Robert W. Depke - Juvenile Justice Complex **RTU Replacement**

24647 N MILWAUKEE AVE, VERNON HILLS, IL 60061

ISSUED FOR BID JUNE 18TH, 2018


EXP US SERVICES PROJECT NUMBER: CHI-00240054-A1 FOR: LAKE COUNTY FACILITIES

BY: EXP U.S. SERVICES ENGINEERS/ ARCHITECTS/ PLANNERS 205 NORTH MICHIGAN AVENUE CHICAGO, IL 60601 312.616.000





Robert W. Depke - Juvenile Justice Complex 24647 N MILWAUKEE AVE, VERNON HILLS, IL 60061

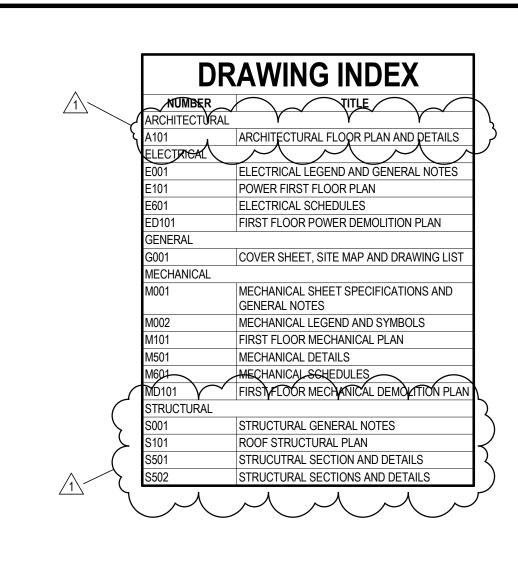

exp U.S. Services Inc.

www.exp.com


t: +1.312.616.0000 f: +1.312.616.6069 205 North Michigan Avenue, Suite 3600 Chicago, IL 60601


[©]exp.

PROJECT SITE MAP NTS



BUILDINGS • EARTH & ENVIRONMENT • E INDUSTRIAL • INFRASTRUCTURE • SUSTAIL CAUTION: DO NOT SCALE DRAWINGS.	NABILITY •
THIS REPRODUCTION MAY BE AT A SIZE DIFFERENT THAN ORIGINALLY DRAWN, NO RESPONSIBILITY FOR INCORRECT SCALING, UNAUTHORIZED REPRODUCTIO STRICTLY PROHIBITED. NOT PUBLISHED - ALL RIGHTS RESERVED. EXP EXPRES RESPONSIBILITY ARISING FROM UNAUTHORIZED USE OF THESE DRAWINGS AN AUTHORIZATION MUST BE IN WRITING. © exp, 2012	N OR REUSE IS SLY DISCLAIMS
Image:	
	VED FOR BID
	ATI
	RUCTURE • SUSTAINABILITY • TOTAL PARAMETER SUSTAINABILITY • TOTAL PARAME
Project Title	
Juvenile Justice Comp	
24647 N Milwaukee Ave,	
COVER SHEET, SIT	
Project No. CHI-00240054-A1	
Dwg. No. Rev.	No.

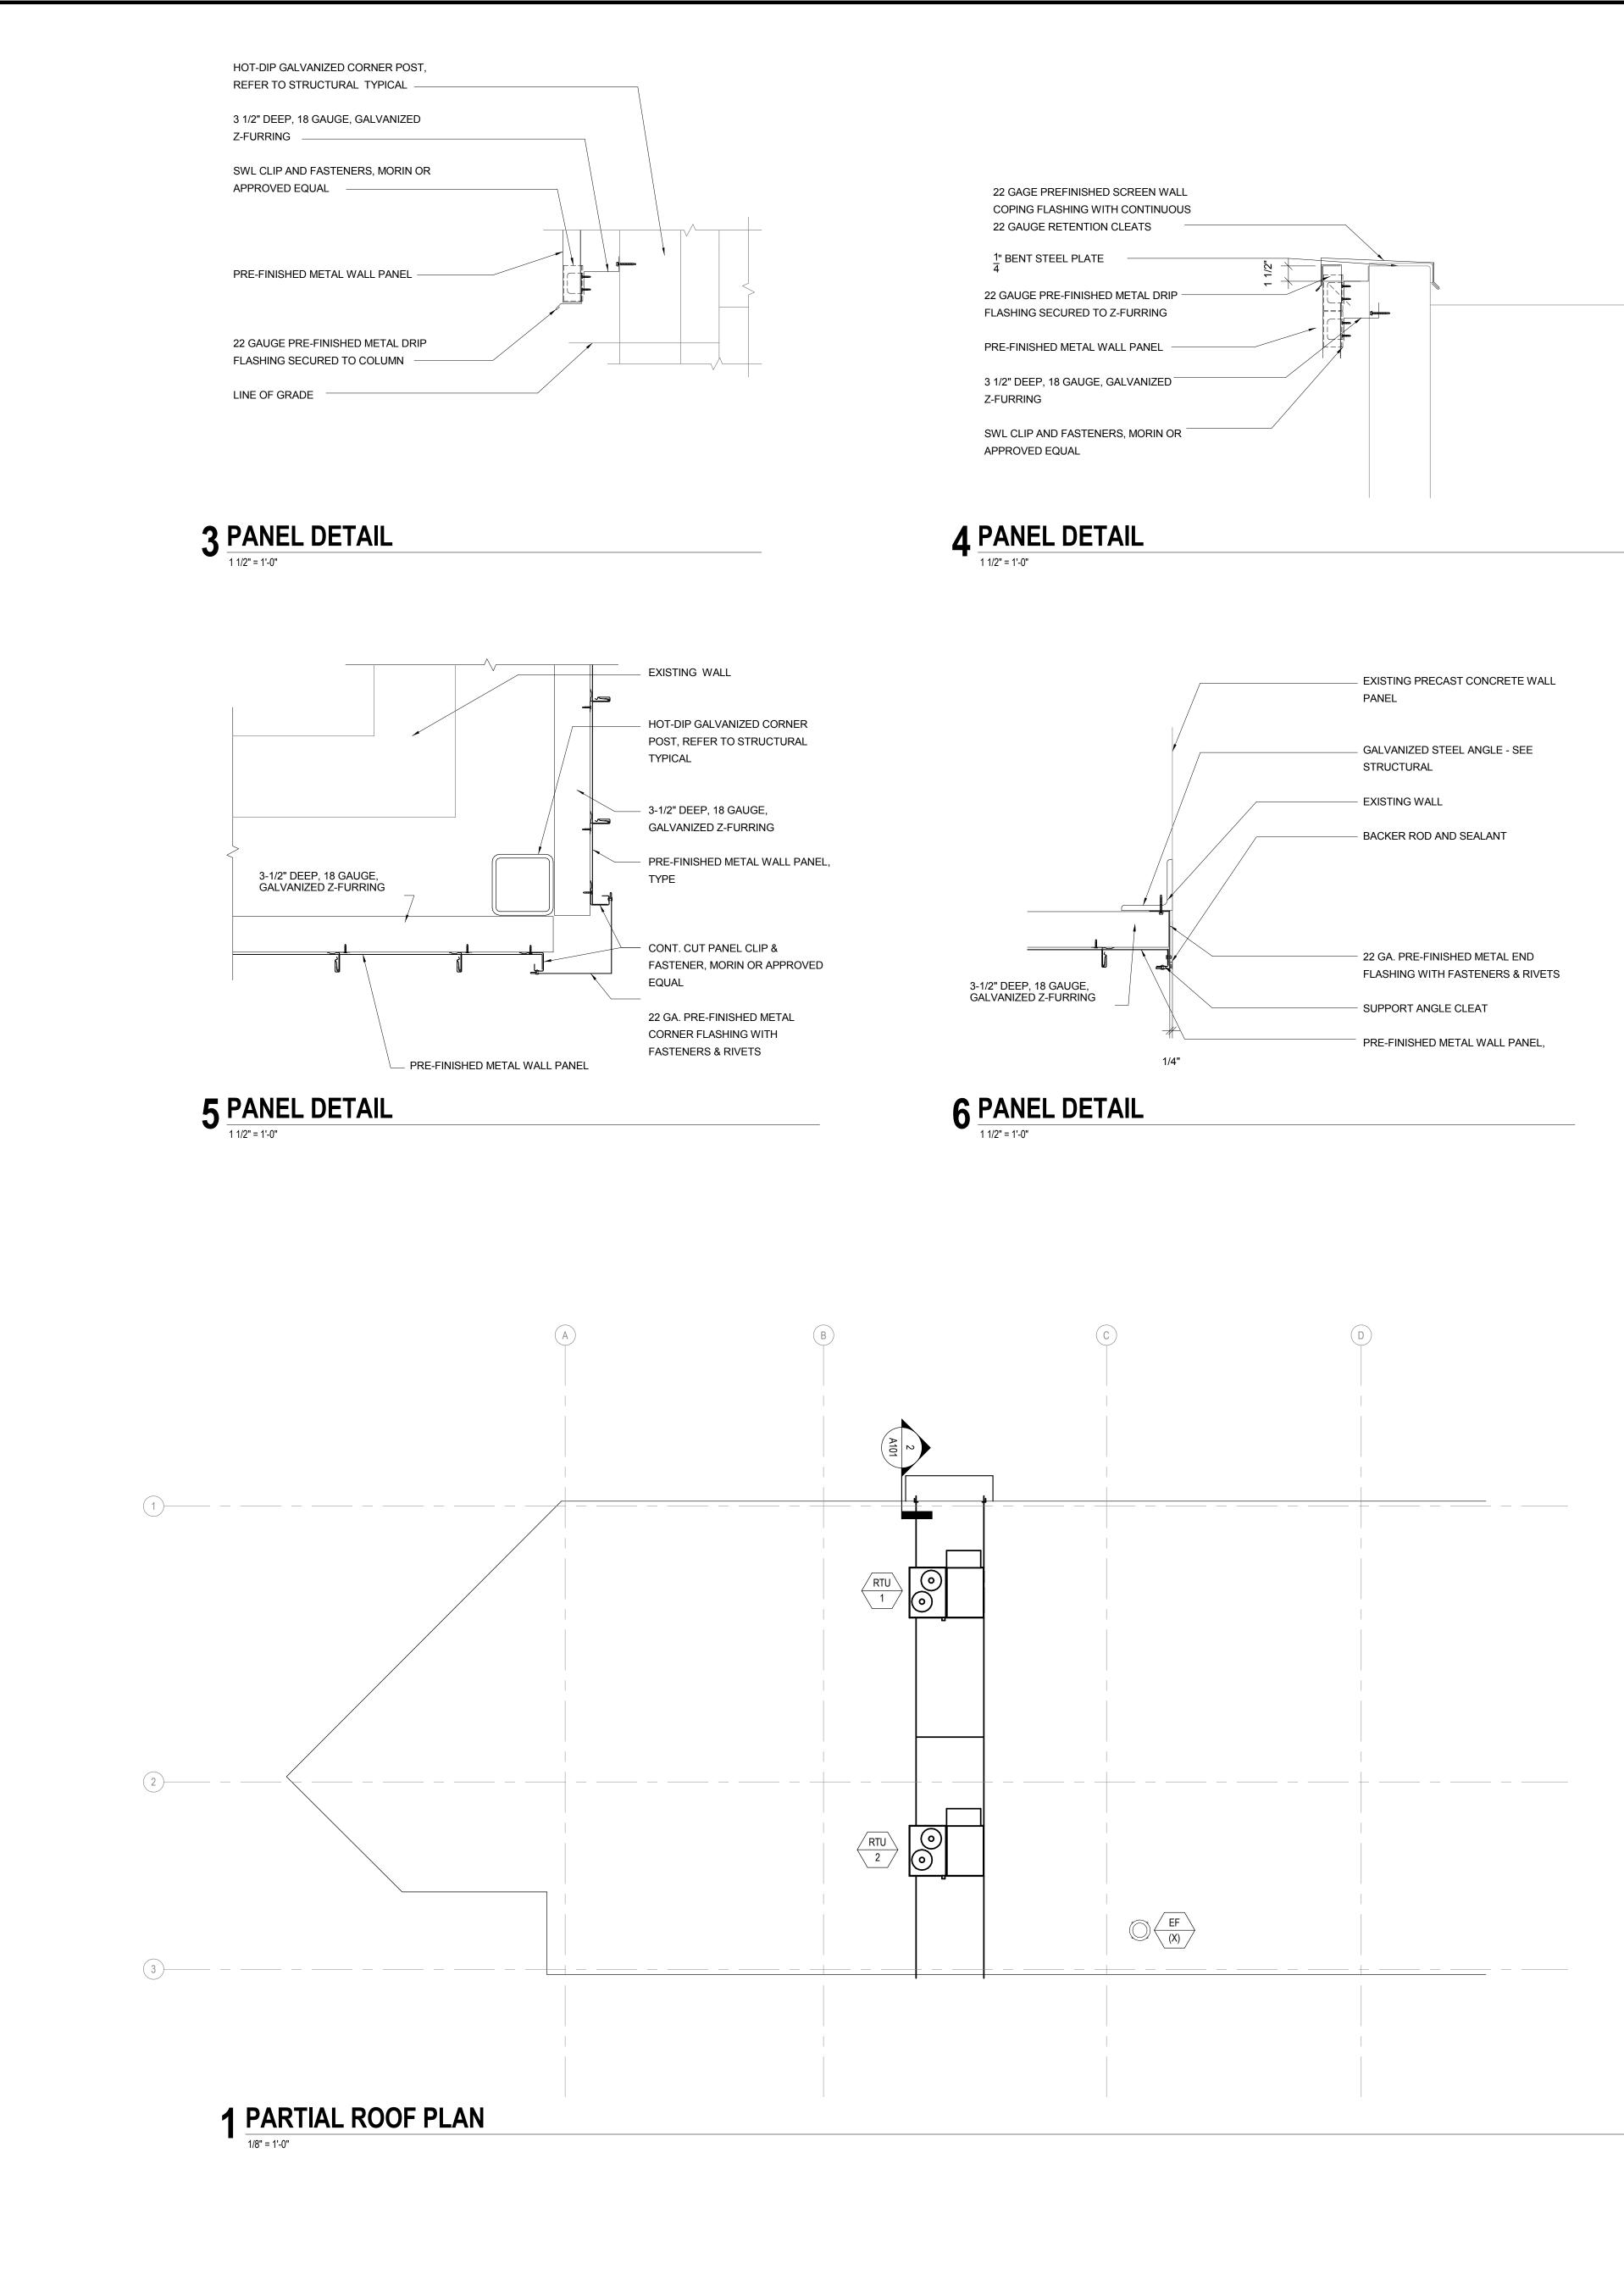

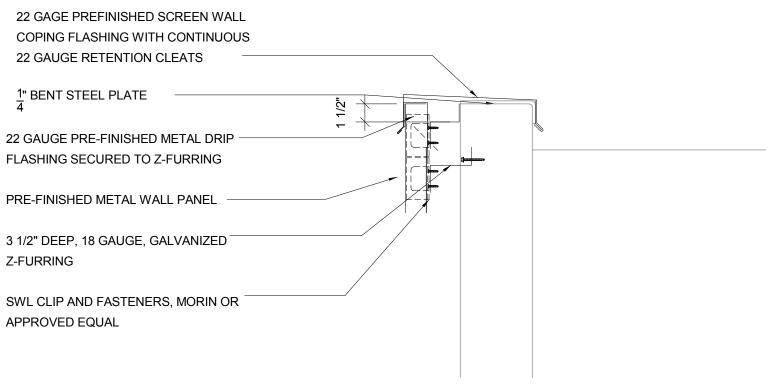


B.O. PANEL T.O. GRADE



|--|

CONTRACTOR TO FIELD VERIFY ALL DIMENSIONS AND COORDINATE WITH STRUCTURAL FOR ANY ADDITIONAL REQUIREMENT.

SHEET KEYNOTES

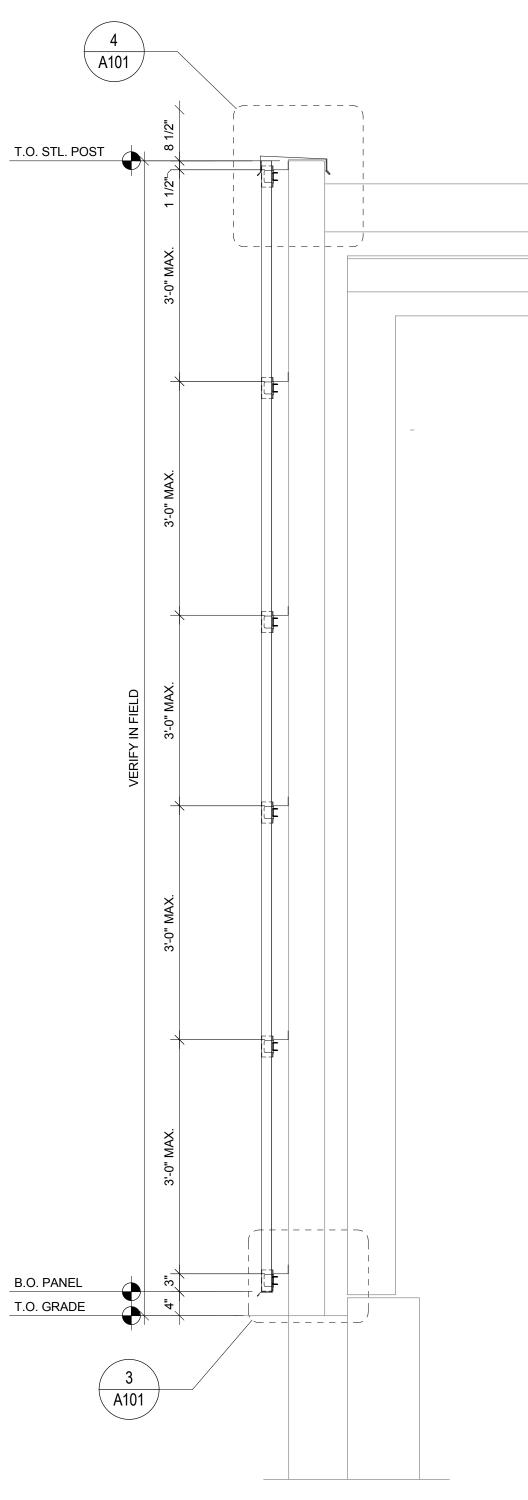

2 VERTICAL PANEL SECTION VIEW

SCALE: 1/8" = 1'-0

		JJ JW LB 3.2018 054-A1.rfa Depke Complex Cement kee Ave, - 60061
1 No.	ADDENDUM #1 Revision	
No.	Revision	
No.	Revision ISSUED FOR BID sional Seal(s)	
No.	Revision ISSUED FOR BID sional Seal(s) By: AJJ	
No. Profes Drawn Check	Revision ISSUED FOR BID sional Seal(s) By: AJJ ed By: AJW ved By: MLB	
No. Profes Drawn Check Appro	Revision ISSUED FOR BID sional Seal(s) By: AJJ ed By: AJW ved By: MLB Printed: 06.18.2018	
No. Profes Drawn Check Appro Date F	Revision ISSUED FOR BID sional Seal(s) By: AJJ ed By: AJW ved By: MLB printed: 06.18.2018 ame: CHI-00240054-A1.rfa	Date
No. Profes Drawn Check Appro Date F File Na Project	Revision ISSUED FOR BID sional Seal(s) By: AJJ ed By: AJW ved By: MLB Printed: 06.18.2018 ame: CHI-00240054-A1.rfa tTitle Robert W. Depke Juvenile Justice Comp RTU Replacement 24647 N Milwaukee Ave, Vernon Hills, IL 60061	Date OR BID
No. Profes Drawn Check Appro Date F File Na Project	Revision ISSUED FOR BID sional Seal(s) By: AJJ ed By: AJW ved By: MLB Printed: 06.18.2018 ame: CHI-00240054-A1.rfa tTitle Robert W. Depke Juvenile Justice Comp RTU Replacement 24647 N Milwaukee Ave, Vernon Hills, IL 60061 Title RCHITECTURAL FLO PLAN AND DETAILS	Revision Date D FOR BID AJJ AJJ AJW MLB 06.18.2018 06.18.2018 HI-00240054-A1.rfa t W. Depke ustice Complex Replacement N Milwaukee Ave, on Hills, IL 60061 CTURAL FLOOR ND DETAILS O240054-A1

• BUILDINGS • EARTH & ENVIRONMENT • ENERGY • INDUSTRIAL • INFRASTRUCTURE • SUSTAINABILITY CAUTION: DO NOT SCALE DRAWINGS. THIS REPRODUCTION MAY BE AT A SIZE DIFFERENT THAN ORIGINALLY DRAWN. EXP ASSUMES NO RESPONSIBILITY FOR INCORRECT SCALING. UNAUTHORIZED REPRODUCTION OR REUSE IS STRICTLY PROHIBITED. NOT PUBLISHED - ALL RIGHTS RESERVED. EXP EXPRESSLY DISCLAIMS RESPONSIBILITY ARISING FROM UNAUTHORIZED USE OF THESE DRAWINGS AND NOTES. AUTHORIZATION MUST BE IN WRITING. exp, 2012

t: +1.312.616.0000 f: +1.312.616.6069 205 North Michigan Avenue, Suite 3600 Chicago, IL 60601 USA www.exp.com

exp U.S. Services Inc.

ELECTRICAL NOTES:

1. DEFINITIONS

"FURNISH" MEANS TO SUPPLY AND DELIVER OF AN ITEM OF EQUIPMENT TO THE PROJECT SITE, READY FOR INSTALLATION.

"INSTALL" MEANS TO SET IN PLACE, CONNECT AND PLACE IN FULL OPERATIONAL ORDER. "PROVIDE" MEANS TO "FURNISH" AND "INSTALL".

"EQUIVALENT" MEANS TO MEET THE SPECIFICATIONS OF THE REFERENCED PRODUCT OR ITEM ON ALL SIGNIFICANT ASPECTS, WHERE SIGNIFICANT ASPECTS SHALL BE DETERMINED BY THE ENGINEER.

"FUTURE", "REFER (DISCIPLINE) DIVISION" AND SIMILAR EXPRESSIONS INDICATE WORK THAT MAY BE PERFORMED UNDER THE CONTRACT DOCUMENTS BUT, NOT NECESSARILY UNDER THE DIVISION OR DISCIPLINE ON WHICH THE NOTE APPEARS. THE CONTRACTOR SHALL BE RESPONSIBLE FOR COORDINATING THE WORK WITH SUPPLIERS, SUBCONTRACTORS, EMPLOYEES, ETC. SHOULD CLARIFICATION OF ANY PORTION OF THE WORK BE REQUIRED, CONTACT THE ARCHITECT/ENGINEER PRIOR TO SUBMITTING BID.

2. CODES

THE WORK SHALL COMPLY WITH ALL APPLICABLE LOCAL, MUNICIPAL, AND NATIONAL CODES. THIS WOULD INCLUDE, BUT IS NOT LIMITED TO, THE CURRENT CITY BUILDING CODE, NFPA, ANSI, OSHA, AND ALL OTHER LOCAL OR MUNICIPAL BUREAUS AND DEPARTMENTS WHICH HAVE AUTHORITY OVER THE PROJECT; ANYTHING IN THESE CONTRACT DOCUMENTS NOT WITHSTANDING. THIS SHALL NOT BE CONSTRUED AS WAIVING COMPLIANCE WITH ANY REQUIREMENTS OF THE PLANS AND SPECIFICATIONS WHICH MAY BE IN EXCESS OF ANY REQUIREMENTS OF THESE CODES.

3. INTERPRETATION OF THE DOCUMENTS

THE CONTRACTOR SHALL CAREFULLY COMPARE THE DRAWINGS AND SPECIFICATIONS, CHECKING THE MEASUREMENTS AND CONDITIONS UNDER WHICH CONSTRUCTION IS TO BE IMPLEMENTED. FOR CLARIFICATION BETWEEN VARIOUS DRAWINGS AND/OR SPECIFICATIONS, THE DISPUTED ISSUES SHALL BE REFERRED TO THE ENGINEER BEFORE ANY WORK IS EXECUTED. THE CONTRACTOR SHALL STATE IN THEIR PROPOSAL ANY EXCEPTIONS NECESSARY TO MAKE THIS WORK A COMPLETE AND READY-TO-USE INSTALLATION. IF NOT SO-STATED IN THE CONTRACTOR'S PROPOSAL, ANY SUCH WORK WILL NOT BE CONSIDERED ADDITIONAL.

4. COORDINATION

THE ELECTRICAL DRAWINGS ARE DIAGRAMMATIC IN NATURE AND SHALL NOT BE SCALED. TO THIS EXTENT. THE CONTRACTOR SHALL COORDINATE THE EXACT LOCATION OF ALL REQUIRED WORK AND EQUIPMENT WITH THAT OF THE OTHER TRADES. WHERE THERE ARE POTENTIAL CONFLICTS, THE CONTRACTOR SHALL OBTAIN AND VERIFY EXACT LOCATIONS, MEASUREMENTS, LEVELS, SPACE REQUIREMENTS, ETC. AT THE SITE AND SHALL SATISFACTORILY ADAPT HIS WORK TO ACTUAL FIELD CONDITIONS.

REFER TO ARCHITECTURAL/MECHANICAL DRAWINGS FOR PLANS, ELEVATIONS AND DETAILS INDICATING THE LOCATIONS OF CEILING ELEMENTS (E.G., LIGHTS, SPRINKLERS, DIFFUSERS, ETC.) AND WALL ELEMENTS. CEILING MOUNTED ITEMS SHALL BE INSTALLED IN ACCORDANCE WITH THE ARCHITECTURAL REFLECTIVE CEILING PLANS. IF LOCATION FOR AN ITEM IS NOT SHOWN ON THE ARCHITECTURAL DRAWINGS, VERIFY THE EXACT LOCATION OF THE ITEM WITH THE ARCHITECT PRIOR TO INSTALLATION. THESE REQUIREMENTS APPLY TO ALL CEILING TYPES IN ALL AREAS.

5. SITE EXAMINATION

THE CONTRACTOR SHALL VISIT THE SITE, EXAMINE THE PREMISES, AND MAKE A THOROUGH SURVEY OF THE CONDITIONS UNDER WHICH CONSTRUCTION WILL BE IMPLEMENTED. THE SUBMISSION OF A PROPOSAL WILL BE CONSTRUED AS EVIDENCE THAT SUCH AN EXAMINATION HAS BEEN MADE AND, ANY LATER CLAIMS FOR LABOR, EQUIPMENT, OR MATERIALS REQUIRED FOR DIFFICULTIES ENCOUNTERED WHICH COULD HAVE BEEN FORESEEN HAD SUCH AN EXAMINATION BEEN MADE, WILL NOT BE RECOGNIZED.

6. PERMITS

THE CONTRACTOR SHALL OBTAIN AND PAY FOR ALL PERMITS, INSPECTIONS, AND FEES REQUIRED FOR THE EXECUTION OF THIS WORK. SCHEDULING OF ALL REQUIRED INSPECTIONS SHALL BE THE RESPONSIBILITY OF THE CONTRACTOR.

7. SAFETY

THE CONTRACTOR SHALL TAKE ALL STEPS NECESSARY TO ENSURE THE SAFETY OF THE CLIENT'S EMPLOYEES, BUILDING EMPLOYEES AND GUESTS AS WELL AS THEIR OWN FORCES, BY ADEQUATELY PROTECTING ANY EXPOSED LIVE CABLE, EQUIPMENT, OR DEVICES

8. FIRESAFING / FIRE ALARM

THROUGHOUT THE COURSE OF THIS WORK.

ALL PENETRATIONS IN WALLS, FLOORS, OR CEILINGS SHALL BE SUITABLY CLOSED UP AND SEALED WITH HILTI CAULK. ALL MECHANICAL/ELECTRICAL EQUIPMENT INSTALLED SHALL BE INTEGRATED INTO OWNERS FIRE ALARM SYSTEM AS REQUIRED.

9. CABLING

UNLESS NOTED OTHERWISE, ALL WIRE AND CABLE SHALL BE 600-VOLT COPPER CONDUCTORS WITH TYPE "THHN/THWN" INSULATION. MINIMUM WIRE SIZE SHALL BE #12 AWG FOR LIGHTING AND POWER CIRCUITS AND #14 AWG FOR CONTROL CIRCUITS. PROVIDE GROUNDING FOR CIRCUITS PER THE NEC. UNLESS SPECIFICALLY NOTED OTHERWISE IN THE PLANS, ALL CABLING SHALL BE (2) #12 AND (1) #12 G IN 3/4" C.

10. CABLE SIZING

OTHERWISE INDICATED:

BRANCH CIRCUIT CABLE SIZE SHALL BE ADJUSTED BASED ON THE CONDUCTOR LENGTH, AS INDICATED BELOW:

A. 120/208V CABLING FROM PANEL TO ELECTRICAL LOAD SHALL BE AS FOLLOWS, UNLESS

LESS THAN 100 FEET, USE #12 AWG MINIMUM FROM 100 TO 200 FEET, USE #10 AWG MINIMUM

FROM 200 TO 250 FEET, USE #8 AWG MINIMUM
B. 277/480V CABLING FROM PANEL TO ELECTRICAL LOAD SHALL BE AS FOLLOWS, UNLESS OTHERWISE INDICATED:

FROM 0 TO 150 FEET, USE #12 AWG MINIMUM FROM 150 TO 250 FEET, USE #10 AWG MINIMUM FROM 250 TO 300 FEET, USE #8 AWG MINIMUM

11. CONDUIT/RACEWAY SYSTEMS

THE CONDUIT ROUTINGS INDICATED ARE ONLY DIAGRAMMATIC IN NATURE. FIELD CONDITIONS SHALL DICTATE THE CONTRACTOR'S EXACT CONDUIT ROUTING. THE CONTRACTOR SHALL BE RESPONSIBLE FOR SIZING AND LOCATING PULL BOXES PER NEC AND FOR COORDINATION WITH OTHER DISCIPLINES, ALL EXPOSED RACEWAYS S BE INSTALLED PARALLEL OR PERPENDICULAR TO WALLS OR STRUCTURAL MEMBERS, AS TO FOLLOW STRUCTURAL SURFACE CONTOURS AND NOT OBSTRUCT PASSAGEWA MULTIPLE RACEWAYS SHALL BE RUN TOGETHER, IN GROUPING. ALL CONTROLS WIRIN SHALL BE IN BLUE CONDUIT. ALL EXPOSED CONDUIT SHALL BE ROUTED PERPENDICU PARALLEL AND TIGHT TO COLUMNS AND BEAMS. ALL EXPOSED CONDUIT SHALL BE COORDINATED WITH THE ARCHITECT/ENGINEER PRIOR TO INSTALLATION. EXTRA TIM SHOULD BE ALLOWED FOR THIS REVIEW AND APPROVAL. NO ADDITIONAL COST TO OW WILL BE ALLOWED DUE TO LACK OF COORDINATION. UNLESS NOTED OTHERWISE, ALL CONDUIT SHALL BE ELECTRICAL METALLIC TUBING (B MINIMUM SIZE SHALL BE 3/4" C. CONNECTORS AND COUPLINGS SHALL BE INSULATED-THROAT COMPRESSION TYPE ONLY. RIGID GALVANIZED-STEEL (RGS) COM SHALL BE USED WHEN CONDUIT IS INSTALLED IN OUTDOOR AREAS OR WHERE OTHER EXPOSED TO PHYSICAL DAMAGE.

EMERGENCY SYSTEMS SHALL BE RUN IN SEPARATE RACEWAY/CONDUIT SYSTEM(S). A SEPARATE INSULATED EQUIPMENT GROUNDING CONDUCTOR SHALL BE PULLED WIT CIRCUIT CONDUCTORS, WHETHER OR NOT INDICATED ON THE DRAWINGS. METAL RAC OR CABLE ARMOR/SHEATH SHALL NOT BE USED AS THE PRIMARY EQUIPMENT GROUN CONDUCTOR. RACEWAY SYSTEMS SHALL BE MECHANICALLY AND ELECTRICALLY CONTINUOUS AND SHALL BE BONDED AT ALL POINTS TO THE INSULATED EQUIPMENT GROUNDING CONDUCTOR IN ACCORDANCE WITH THE APPLICABLE PROVISIONS IN ART 250 OF THE NEC. REFER TO THE ARCHITECTURAL DRAWINGS FOR PAINTING OF RACEWAY.

<u>13. EQUIPMENT</u>

ALL MATERIALS AND EQUIPMENT PROVIDED IN THIS WORK SHALL BE NEW AND SHALL THE APPROPRIATE UL LISTING AND/OR FM APPROVAL. UNLESS NOTED OTHERWISE, DISCONNECT/SAFETY SWITCHES SHALL BE NON-FUSED HEAVY-DUTY 240-VOLT TYPE. INDOOR ENCLOSURES SHALL BE NEMA 1 AND OUTDOOR ENCLOSURES SHALL BE NEM.

14. DEVICE BOXES AND RECEPTACLES

UNLESS SPECIFICALLY NOTED OTHERWISE IN THE PLANS, DEVICE BOXES SHALL BE 4-SQURE GALVANIZED-STEEL, PROVIDED BLANK COVERS, PLASTER RINGS AND DEVICE (PLATES AS REQUIRED.

WEATHERPROOF RECEPTACLE BOXES SHALL BE CAST FERALOY TYPE "FS" OR "FD". T "FD" CAST BOXES SHALL BE USED WHEN DEVICE DEPTH EXCEEDS 1 5/8". ALL COVERS PLATES FOR "FS" AND "FD" BOXES SHALL BE PROVIDED WITH LIP AND PROPER GASKE" ALL WEATHERPROOF RECEPTACLES SHALL BE COMPLETE WITH CAST OUTLET BOX, DI GFI RECEPTACLE (20A-125V-3 WIRE) AND CORROSION RESISTANT PLATE.

15. PANELBOARDS

ALL PANELBOARDS IN WHICH WORK OCCURS PER THESE DOCUMENTS, SHALL BE PRO WITH UPDATED-TYPEWRITTEN DIRECTORIES. GIVEN ONLY FOR CLARITY AND QUANTIT CIRCUIT NUMBERS SHOWN IN THE PLANS MAY NOT NECESSARILLY REPRESENT ACTUA CIRCUIT NUMBERS IN PANELBOARD.

ELECTRICAL COMPONENTS, DEVICES AND ACCESSORIES: LISTED AND LABELED AS DE IN NFPA 70, BY QUALIFY TESTING AGENCY AND MARKED FOR INTENDED LOCATION AND APPLICATION.

16. MECHANICAL EQUIPMENT

ALL MECHANICAL EQUIPMENT WILL BE INSTALLED BY THE DIVISION 15 CONTRACTOR. COORDINATE THE EXACT LOCATION AND NATURE OF ANY REQUIRED ELECTRICAL CONNECTION TO BE PROVIDED FOR MECHANICAL EQUIPMENT PRIOR TO ROUGH-IN.

VERIFY THE ELECTRICAL SERVICE REQUIRED FOR EACH ITEM OF MECHANICAL EQUIPM WITH THE MECHANICAL CONTRACTOR PRIOR TO FURNISHING SUCH POWER. REFER MECHANICAL DRAWING FOR MECHANICAL EQUIPMENT REQUIRING ELECTRICAL CONNECTIONS. MAKE CONNECTION AND PROVIDE APPROPRIATE WIRE, CONDUIT AND OVERCURRENT PROTECTION FOR EQUIPMENT. THE DISCONNECTING MEANS FOR ALL MECHANICAL EQUIPMENT SHALL BE ACCESSIBLE AND HAVE CLEARANCES AS REQUIRE THE NEC.

MOTORS SHALL BE FURNISHED AND INSTALLED UNDER DIVISION 23 WORK, WITH POWE CONNECTED UNDER DIVISION 26 WORK. FINAL CONNECTION SHALL BE MADE WITH SUITABLE LENGTH OF LIQUID-TIGHT FLEXIBLE METALLIC CONDUIT. ALL MOTOR BRANC CIRCUITS, ETC., SHALL BE FIELD-VERIFIED FOR PROPER SEQUENCE AND MOTOR ROTA PHASE SEQUENCE SHALL BE A-B-C (VIEWED FROM FRONT: LEFT TO RIGHT, TOP TO BO FRONT TO REAR). REFER TO MECHANICAL DRAWINGS FOR MOTORS THAT ARE TO BE INTERLOCKED.

PROVIDE ALL NECESSARY ELECTRICAL EQUIPMENT AND CONNECTIONS REQUIRED FO HVAC SHUTDOWN DURING A FIRE ALARM CONDITION. COORDINATION FOR THE EXACT CONNECTION AND EQUIPMENT REQUIRED TO BE PROVIDED BEFORE ROUGH-IN.

17. MISCELLANEOUS SUPPORTING MEMBERS

ALL ANGLES, CHANNELS, AND OTHER MISCELLANEOUS STEEL, BOLTS, THREADED RODS, ETC., REQUIRED TO SUPPORT LIGHT FIXTURES, LADDER TRAY OR OTHER ELECTRICAL EQUIPMENT OR DEVICES SHALL BE FURNISHED AND INSTALLED BY THE CONTRACTOR. ALL THREADED RODS SHALL BE A MINIMUM OF 5/8" IN DIAMETER.

29/2018 8:53:32 AM F:\Doc_exp\CHI-00240054-A1\REVIT_This Project Uses Revit 2016 [To Be Conf

			A	AMPERES
	<u>19.</u>	DEMOLITION, RELOCATION AND ALTERATION	AAC	ABOVE ACCESSIBLE
			AC	ALTERNATING CURR
		PROVIDE REMOVAL, RELOCATION, REROUTING AND RECONNECTION OF EXISTING ELECTRICAL SYSTEMS, AS REQUIRED TO ACCOMPLISH ALTERATION, RESTORATION AND	ADA	AMERICANS WITH DI
THE		NEW WORK. VERIFY THAT ALL REUSED EQUIPMENT IS IN GOOD WORKING ORDER.	AF	AMPERE FRAME
HALL SUCH		ALL MATERIAL AND/OR EQUIPMENT INDICATED FOR SALVAGE SHALL BE DELIVERED TO THE	AFCI	ARC FAULT CIRCUIT
YS.		LOCATION DIRECTED BY THE OWNER. ALL LIGHTING FIXTURES TO BE DEMOLISHED SHAL HAVE THEIR BALLAST AND LAMPS REMOVED AND DELIVERED TO THE LOCATION DIRECTED	AFF	ABOVE FINISHED FLC
IG ILAR,		BY THE OWNER. ALL OTHER DEMOLITION MATERIAL SHALL BECOME THE PROPERTY OF THE	AFG	ABOVE FINISHED GR
E		CONTRACTOR AND SHALL BE PROPERLY REMOVED FROM THE SITE.	AFU	AMPERE FUSE
WNER		ALL ELECTRICAL OPENINGS NOT USED SHALL BE CAPPED AND SEALED.	AIC	AMPERES INTERRUF SYMMETRICAL
EMT).		EXISTING CONDITIONS WERE OBTAINED FROM AVAILABLE DRAWINGS AND ARE NOT GUARANTEED TO BE COMPLETE OR CORRECT. THE CONTRACTOR SHALL SURVEY AND	AL	ALUMINUM
NDUIT		VERIFY EXISTING CONDITIONS PRIOR TO SUBMITTING BID AND STARTING WORK.	ARCH	ARCHITECT
RWISE			AS	AMP SWITCH
	20.	CONTRACTOR'S DRAWING REVIEW	AT	AMP TRIP
			ATS	AUTOMATIC TRANSF
		ALL CONTRACTORS/BIDDERS SHALL HAVE RECEIVED A COMPLETE SET OF CONSTRUCTION DOCUMENTS FOR REVIEW AND REFERENCE TO WORK INDICATED. CONDUIT LOCATE	AWG	AMERICAN WIRE GAU
CEWAY		SERVICES SHALL BE REQUESTED AND COMPLETED BEFORE DISTURBANCE OF ANY EXISTING	BFG	BELOW FINISHED GR
		GRADE OR ON-GRADE CONSTRUCTION, SLAB DEMOLITION, OR OTHER ACTIVITIES THAT MAY IMPACT BURIED UTILITIES OR COMMUNICATION CONDUITS. THE CONTRACTOR SHALL	BKBD	BACKBOARD
TICLE		CONFIRM THAT CONDUIT LOCATE SERVICES HAVE BEEN COMPLETED AND THAT NO	C	CONDUIT
		POTENTIAL CONFLICTS EXIST BEFORE EXISTING GRADE IS EXCAVATED OR EXISTING FLOORING DEMOLISHED, REGARDLESS OF THE LOCATION ON THE PROPERTY. THIS SHALL	CAT	CATALOG
		BE REVIEWED WITH THE OWNER'S PROJECT REPRESENTATIVE.	СВ	CIRCUIT BREAKER
			CFCI	CONTRACTOR FURN
	21.	WORK PERFORMANCE REQUIREMENTS		CONTRACTOR INSTA
			СКТ	CIRCUIT
HAVE		ANY PENETRATIONS OR OPENINGS IN FIRE-RATED PARTITIONS (WALLS OR FLOORS) SHALL	CLG	CEILING
		BE CLOSED AT THE END OF EACH WORK DAY, OR WHENEVER IT IS ANTICIPATED THAT NO FURTHER WORK WILL OCCUR IN THAT OPENING DURING THE DAY. THIS INCLUDES ALL	CO	CONDUIT ONLY
IA 3R.		TEMPORARY OPENINGS. CLOSURE SHALL BE IN COMPLIANCE WITH 3M FIREPROOFING	CONC	CONCRETE
		PRODUCT SPECIFICATIONS. REFER TO THE "G" SHEETS FOR GENERAL FIRESAFING DETAILS.	CONC	
		ALL ROOF PENETRATIONS SHALL BE SEALED WATER-TIGHT AT THE END OF EACH WORK		
		DAY. ALL TEMPORARY WALL AND FLOOR OPENINGS SHALL BE PROTECTED AND MARKED AT ALL TIMES.	CU	
-INCH COVER		PAINTING SHALL BE SCHEDULED SUCH THAT DRYING TIME OCCURS DURING NON-WORKING	СТ	CURRENT TRANSFO
COVEN		HOURS FOR OPERATIONS PERSONNEL COMFORT.		DELTA
YPE		NO WELDING SHALL TAKE PLACE INSIDE OF OPERATING FACILITY WITHOUT THE WRITTEN	DIV	DIVISION
S AND		AUTHORIZATION OF THE OWNER'S PROJECT REPRESENTATIVE. WELDING SHALL NOT TAKE	DIA	DIAMETER
TS. UPLEX		PLACE WITHIN 5 FEET OF ANY TELECOM EQUIPMENT RACK WITHOUT ADEQUATE PROTECTIVE MEASURES, AS DEEMED APPROPRIATE BY THE OWNER'S PROJECT	DMM	DIGITAL MULTIMETEI
		REPRESENTATIVE.	DWG	DRAWING
		THE CONTRACTOR SHALL CHECK, VERIFY AND LABEL PHASE ROTATION ANY TIME LEADS	EA	EACH
		ARE CONNECTED TO A NEW OR EXISTING AC SERVICE, GENSET, RECTIFIER OR ANY	EC	EMPTY CONDUIT
		MOTOR-EQUIPPED, 3-PHASE EQUIPMENT.	ELEC	ELECTRICAL
VIDED		ALL THREE-PHASE PANELS SERVING SINGLE-PHASE LOADS SHALL BE BALANCED WITHIN 10	EM	EMERGENCY
TY, AL		PERCENT, USING AMMETER READINGS. MEASUREMENTS SHALL BE TAKEN AT THE END OF CONSTRUCTION AND AGAIN AFTER 30 DAYS IN SERVICE. ALSO REFER TO THE "G" SHEETS	EMT	ELECTRICAL METALL
		FOR ADDITIONAL GENERAL REQUIREMENTS.	EP	EXPLOSION PROOF
EFINED	22	MATERIAL AND EQUIPMENT REQUIREMENTS	EPO	EMERGENCY POWER
D	<u> </u>		EQUIP	EQUIPMENT
		AC DISTRIBUTION BREAKERS SHALL BE LABELED TO IDENTIFY SUBSYSTEM BREAKERS,	EWC	ELECTRIC WATER CO
		PANELS, SYSTEMS, OR CHARGERS SERVED. ALL DISTRIBUTION CIRCUIT BREAKERS SHALL BE CLEARLY LABELED INDICATING THE CIRCUIT SERVED. ALL PANELBOARDS	EXIST	EXISTING
		SHALL BE PROVIDED WITH TYPED DIRECTORIES. ALL PANEL BOARDS AND	EXT	EXTERIOR
		ENCLOSURE CONTAINING LIVE POWER DEVICES SHALL BE PROVIDED WITH COMPLETE LABELING INFORMATION, INCLUDING THE SOURCE OF SUPPLY POWER.	FA	FIRE ALARM
			FAA	FIRE ALARM ANNUN
	00		FIXT	FIXTURE
MENT	<u>23.</u>	STATEMENT OF WORK	FLUOR	FLUORESCENT
		THE CONTRACTOR SHALL PROVIDE THE COMPLETE ELECTRICAL INSTALLATION OF WORK	FT	FEET OR FOOT
C		AS INDICATED IN THE CONSTRUCTION DOCUMENTS. PRIOR TO COMMENCEMENT, THE	FU	FUSE
_ ED BY		CONTRACTOR SHALL SUBMIT FOR REVIEW AND APPROVAL, ANY SEQUENCE OF WORK, MOP'S AND/OR COORDINATION SHOP DRAWINGS FOR THE INTENDED WORK.	G	GROUND
ום סב			GEN	GENERATOR
/ER	7 1	LOSS OF AC	GFCI	GROUND FAULT CIRC
	<u> 24.</u>		GFI	GROUND FAULT INTE
CH ATION.		EQUIPMENT IN THIS BUILDING SHALL NOT HAVE ITS AC SERVICE INTERRUPTED, EVEN	GFP	GROUND FAULT PRO
DTTOM,		MOMENTARILY, WITHOUT PRIOR WRITTEN APROVAL OF AND COORDINATION WITH THE OWNER'S MANAGER. ALL DISRUPTIONS SHALL OCCUR AT TIMES AND OR	HPRS	HORSEPOWER RATE
		DURATIONS ACCEPTABLE TO THE OWNER'S MANAGER. THE CONTRACTOR SHALL	HOA	HAND OFF AUTOMAT
		TAKE ALL STEPS NECESSARY TO MITIGATE THE LENGTH OF THE DISRUPTION.	HP	HORSEPOWER
)R F			HP	

25. LUG REQUIREMENTS

ALL LUGS SHALL BE 2 BOLT LONG BARREL TYPE WITH INSPECTION HOLES PRODUCED WITH NON-FLASHING DYES AS MANUFACTURED BY THOMAS BETTS, MINIMUM 10 TONS HYPRESS COMPRESSION. USE OF HEAT SHRINK TUBING IS NOT PERMITTED. ANY EXISTING CABLE/WIRE DISCONNECTED AS PART OF THE PROJECT SHALL BE RECONNECTED TO EQUIPMENT USING LUG MEETING THIS REQUIREMENT.

А	AMPERES	IG	ISOLATED GROUND
AAC	ABOVE ACCESSIBLE CEILING	INC	INCANDESCENT
AC	ALTERNATING CURRENT	JB	JUNCTION BOX
ADA	AMERICANS WITH DISABILITIES ACT	KCMIL	THOUSAND CIRCULAR MILS
AF	AMPERE FRAME	KVA	KILOVOLT-AMPERES
AFCI	ARC FAULT CIRCUIT INTERRUPTOR	KVAR	KILOVOLT-AMPERES, REACTIVE
AFF	ABOVE FINISHED FLOOR	KW	KILOWATTS
AFG		LCP	LIGHTING CONTROL PANEL
AFU	AMPERE FUSE	LPS	LOW PRESSURE SODIUM
AIC	AMPERES INTERRUPTING CAPACITY, SYMMETRICAL	LTG	LIGHTING
A.1		MAX	
AL ARCH	ALUMINUM	MCB MCC	MAIN CIRCUIT BREAKER
ARCIT	AMP SWITCH	MECH	MECHANICAL
AT	AMP TRIP	MECH	MANUFACTURER
ATS	AUTOMATIC TRANSFER SWITCH	MH	MANHOLE/METAL HALIDE
AWG	AMERICAN WIRE GAUGE	MIN	MINIMUM
BFG	BELOW FINISHED GRADE	MLO	MAIN LUGS ONLY
BKBD	BACKBOARD	MTD	MOUNTED
C	CONDUIT	MTG	MOUNTING
CAT	CATALOG	MVA	MEGAVOLT-AMPERES
СВ	CIRCUIT BREAKER	N	NEUTRAL
CFCI	CONTRACTOR FURNISHED	NA	NOT APPLICABLE
	CONTRACTOR INSTALLED	NC	NORMALLY CLOSED
СКТ	CIRCUIT	NEC	NATIONAL ELECTRICAL CODE
CLG	CEILING	NF	NON FUSED
СО	CONDUIT ONLY	NO	NORMALLY OPEN
CONC	CONCRETE	NTS	NOT TO SCALE
CONT	CONTINUATION	OC	ON CENTER
CU	COPPER	OFCI	OWNER FURNISHED CONTRACTOR INST
СТ	CURRENT TRANSFORMER	OFOI	OWNER FURNISHED OWNER INSTALLED
Δ	DELTA	Ø, PH	PHASE
DIV	DIVISION	PC	PHOTOCELL
DIA	DIAMETER	PIR	PASSIVE INFRARED
DMM	DIGITAL MULTIMETER	POC	POINT OF CONNECTION
DWG	DRAWING	POS	POINT OF SALE
EA	EACH	PLBG	PLUMBING
EC	EMPTY CONDUIT	PT	POTENTIAL TRANSFORMER
ELEC	ELECTRICAL	PVC	POLYVINYL CHLORIDE
EM	EMERGENCY	PWR	POWER
EMT	ELECTRICAL METALLIC TUBING	QTY	QUANTITY
EP	EXPLOSION PROOF	REC	RECESSED
EPO	EMERGENCY POWER OFF	RECPT	RECEPTACLE
EQUIP		REF	
EWC EXIST	ELECTRIC WATER COOLER	RGS	
EXT	EXISTING EXTERIOR	SPST SPDT	SINGLE POLE, SINGLE THROW
FA	FIRE ALARM	SPD	SURGE POLE, DOUBLE THROW
FAA		ST	SHUNT TRIP
FIXT	FIXTURE	SURF	SURFACE
FLUOR	FLUORESCENT	SWBD	SWITCHBOARD
FT	FEET OR FOOT	SWGR	SWITCHGEAR
FU	FUSE	TBD	TO BE DETERMINED
G	GROUND	TELECOM	TELECOMMUNICATIONS
GEN	GENERATOR	TYP	TYPICAL
GFCI	GROUND FAULT CIRCUIT INTERRUPTER	UG	UNDERGROUND
GFI	GROUND FAULT INTERRUPTER	UNO	UNLESS NOTED OTHERWISE
GFP	GROUND FAULT PROTECTION	V	VOLTS
HPRS	HORSEPOWER RATED SWITCH	VFD	VARIABLE FREQUENCY DRIVE
HOA	HAND OFF AUTOMATIC	w	WATTS
HP	HORSEPOWER	WP	WEATHER PROOF
HPS	HIGH PRESSURE SODIUM	XFMR	TRANSFORMER
HZ	HERTZ	Y	WYE

ABBREVIATIONS

GROUNDING AND LIGHTNING PROTECTION

GRU	JUNDING AND LIG		NG PRUIEUIN
	BONDING CONNECTION	— M —	MAIN CONDUCTOR CABLE
0	DOWN CONDUCTOR	— G —	COUNTERPOISE CONDUCTOR CAE
\bigcirc	UP CONDUCTOR	— В —	BONDING CONDUCTOR CABLE
\perp	TEE CONNECTOR	⊥	GROUND ROD
11 	GROUND BUS BAR	=	
• # X	AIR TERMINAL, "#" INDICATES TERMINAL LE A - FLAT SURFACE BASE B - FLAT WALL MOUNTED PARAPET BASE C - SWIVEL BASE D - RIDGE SADDLE BASE (EXPOSED) E - RIDGE SADDLE BASE (CONCEALED) F - CONCEALED AIR TERMINAL BASE ASSEM		TER THAN 18", SUBSCRIPT 'X' INDICA

TAGS AND CALL OUT SYMBOLS

	SECTION CALLOUT		POINT OF CONNECTION
E3.1	 SECTION DESIGNATION SHEET NUMBER 		POINT OF DEMARCATION
	DETAIL CALLOUT	#	REVISION CALLOUT
A E3.1	DETAIL DESIGNATION SHEET NUMBER		KEYNOTE CALLOUT

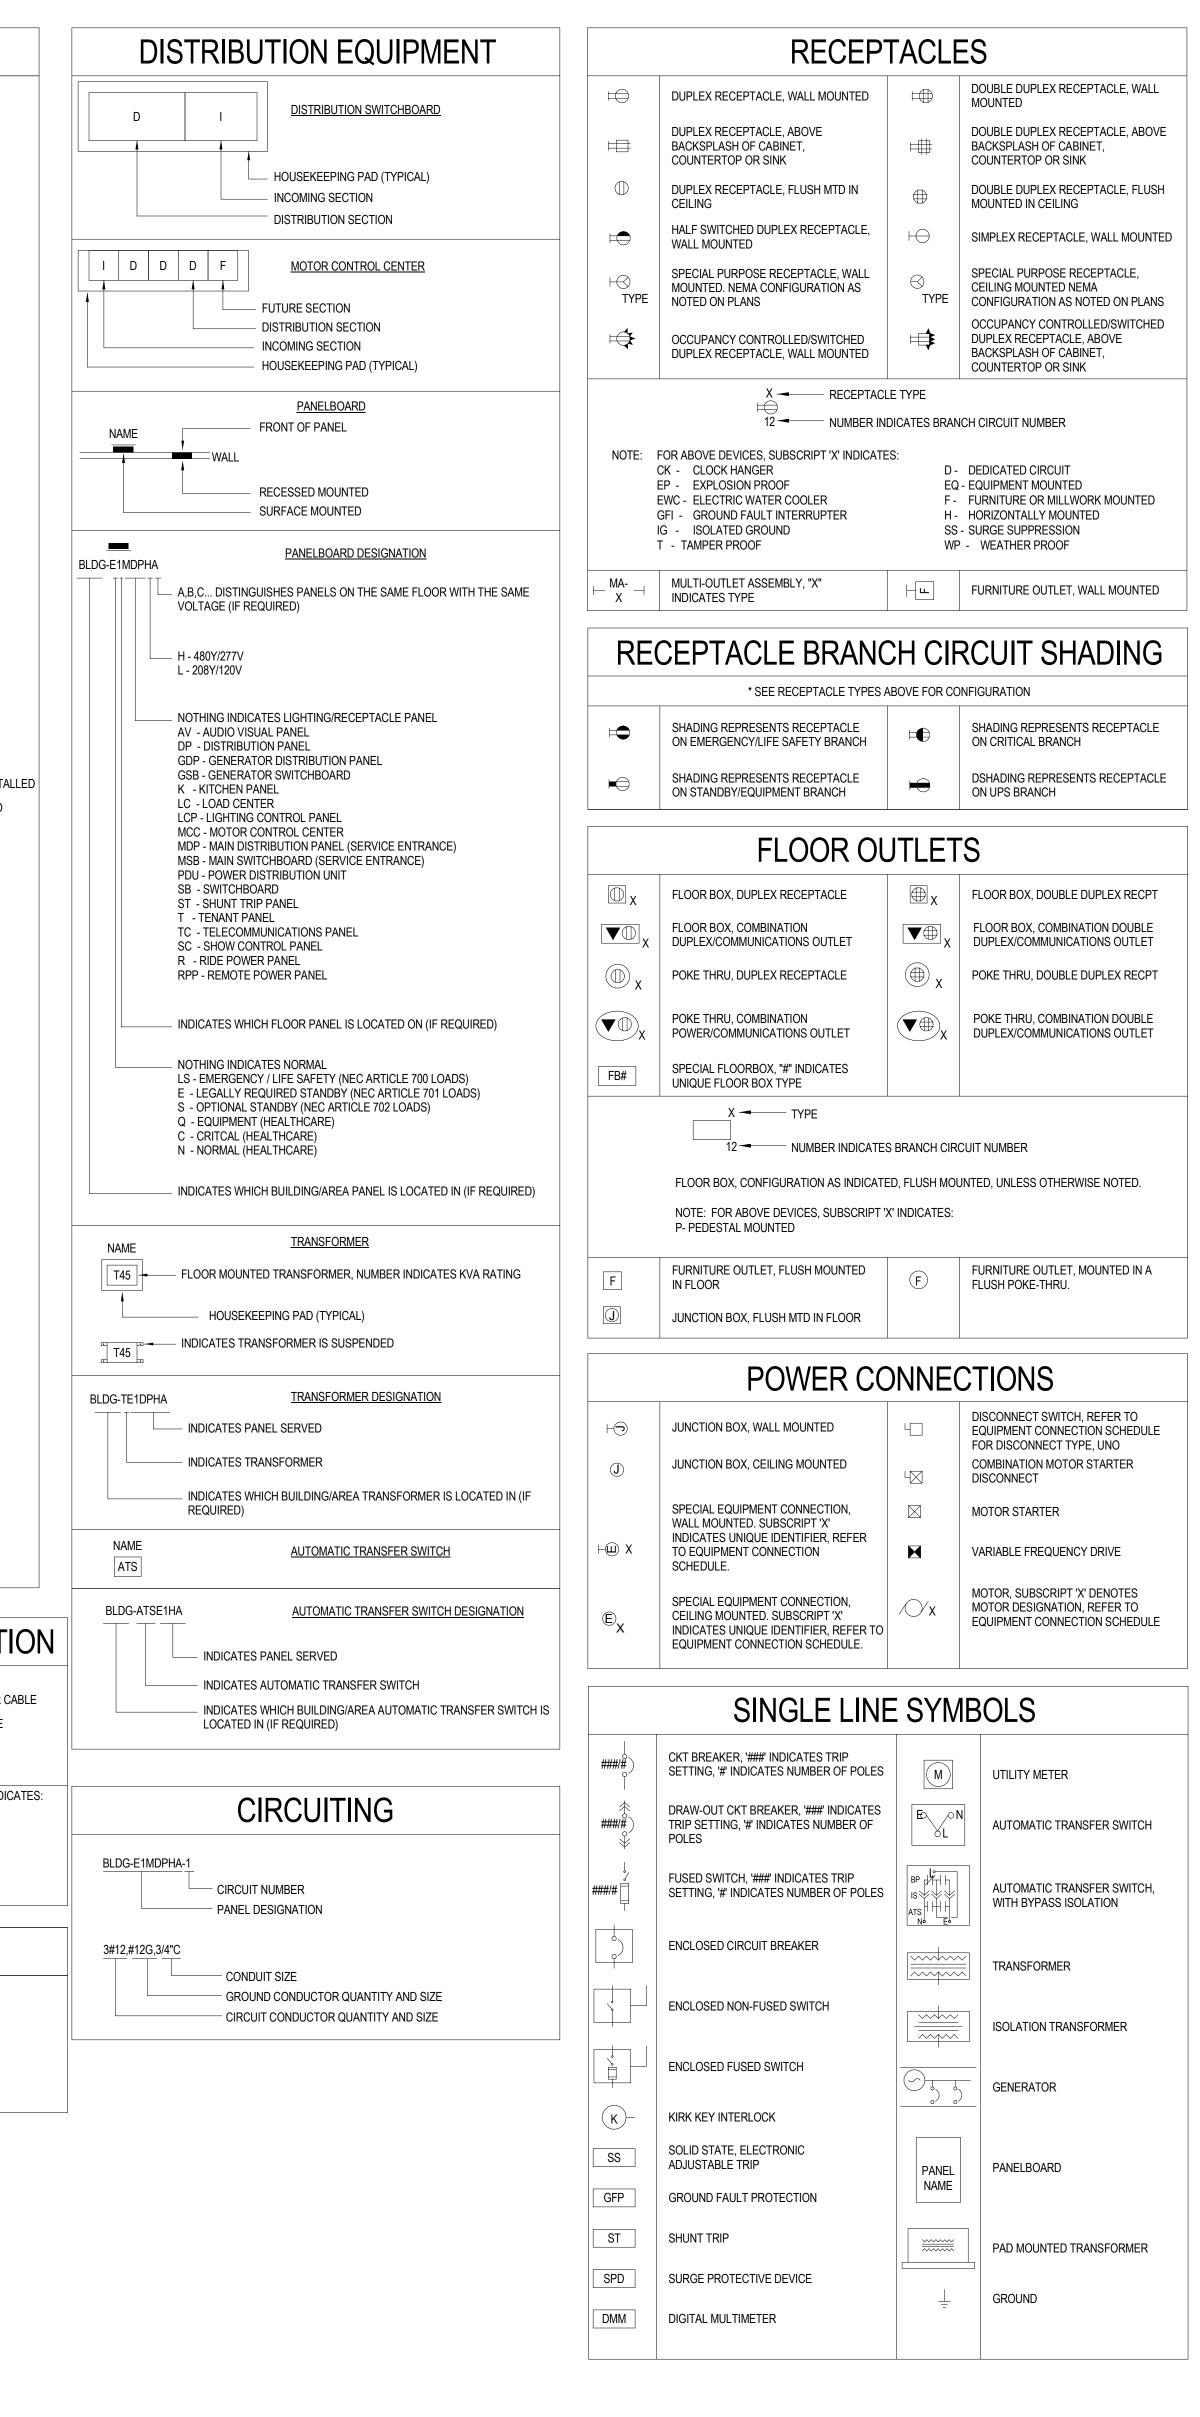


Image: State of the	THIS REF NO RESF STRICTL RESPON	E DO NOT SCALE DRAWINGS. RODUCTION MAY BE AT A SIZE DIFFERENT THAN ORIGINALLY DRAWN. PONSIBILITY FOR INCORRECT SCALING. UNAUTHORIZED REPRODUCTIOI Y PROHIBITED. NOT PUBLISHED - ALL RIGHTS RESERVED. EXP EXPRESS SIBILITY ARISING FROM UNAUTHORIZED USE OF THESE DRAWINGS AND IZATION MUST BE IN WRITING. 112	N OR REUSE IS SLY DISCLAIMS
ISSUED FOR BID Professional Seal(s) Professional Seal(s) Drawn By: HL Checked By: HO Approved By: JFR Date Printed: 06.18.2018 File Name: CHI-00240054-A1.rfa Project Title Robert W. Depke JUVenile Justice Complex RTU Replacement 24647 N Milwaukee Ave,			
ISSUED FOR BID Professional Seal(s) Professional Seal(s) Drawn By: HL Checked By: HO Approved By: JFR Date Printed: 06.18.2018 File Name: CHI-00240054-A1.rfa Project Title Robert W. Depke JUVenile Justice Complex RTU Replacement 24647 N Milwaukee Ave,			
ISSUED FOR BID Professional Seal(s) Professional Se	No.		
ISSUED FOR BID second Seal(s) h By: HL ked By: HO oved By: JFR Printed: 06.18.2018 cmm: CHI-00240054-A1.rfa ct Title Robert W. Depke Juvenile Justice Complex RTU Replacement 24647 N Milwaukee Ave, Vermon Hills, IL 60061 Title ELECTRICAL LEGEND AND GENERAL NOTES ct No. CHI-00240054-A1			
Checked By:HOApproved By:JFRDate Printed:06.18.2018File Name:CHI-00240054-A1.rfaProject TitleRobert W. Depke Juvenile Justice Complex RTU Replacement 24647 N Milwaukee Ave,			
Checked By:HOApproved By:JFRDate Printed:06.18.2018File Name:CHI-00240054-A1.rfaProject TitleRobert W. Depke Juvenile Justice Complex RTU Replacement 24647 N Milwaukee Ave,			
Approved By: JFR Date Printed: 06.18.2018 File Name: CHI-00240054-A1.rfa Project Title Robert W. Depke Juvenile Justice Complex RTU Replacement 24647 N Milwaukee Ave,	Drawn	By: HL	
File Name: CHI-00240054-A1.rfa Project Title Robert W. Depke Juvenile Justice Complex RTU Replacement 24647 N Milwaukee Ave,			
Robert W. Depke Juvenile Justice Complex RTU Replacement 24647 N Milwaukee Ave,			
RTU Replacement 24647 N Milwaukee Ave,		Robert W. Depke	
Vornon Lilla II 60064		RTU Replacement 24647 N Milwaukee Ave,	
Vernon Hills, IL 60061 Dwg. Title	Dwg. T		
Dwg. No. Rev. No.		CHI-00240054-A1	No.
E001		E001	

exp U.S. Services Inc.


Chicago, IL 60601

www.exp.com

+1.312.616.0000 f: +1.312.616.6069 05 North Michigan Avenue, Suite 3600

BUILDINGS
 EARTH & ENVIRONMENT
 ENERGY


• INDUSTRIAL • INFRASTRUCTURE • SUSTAINABILITY

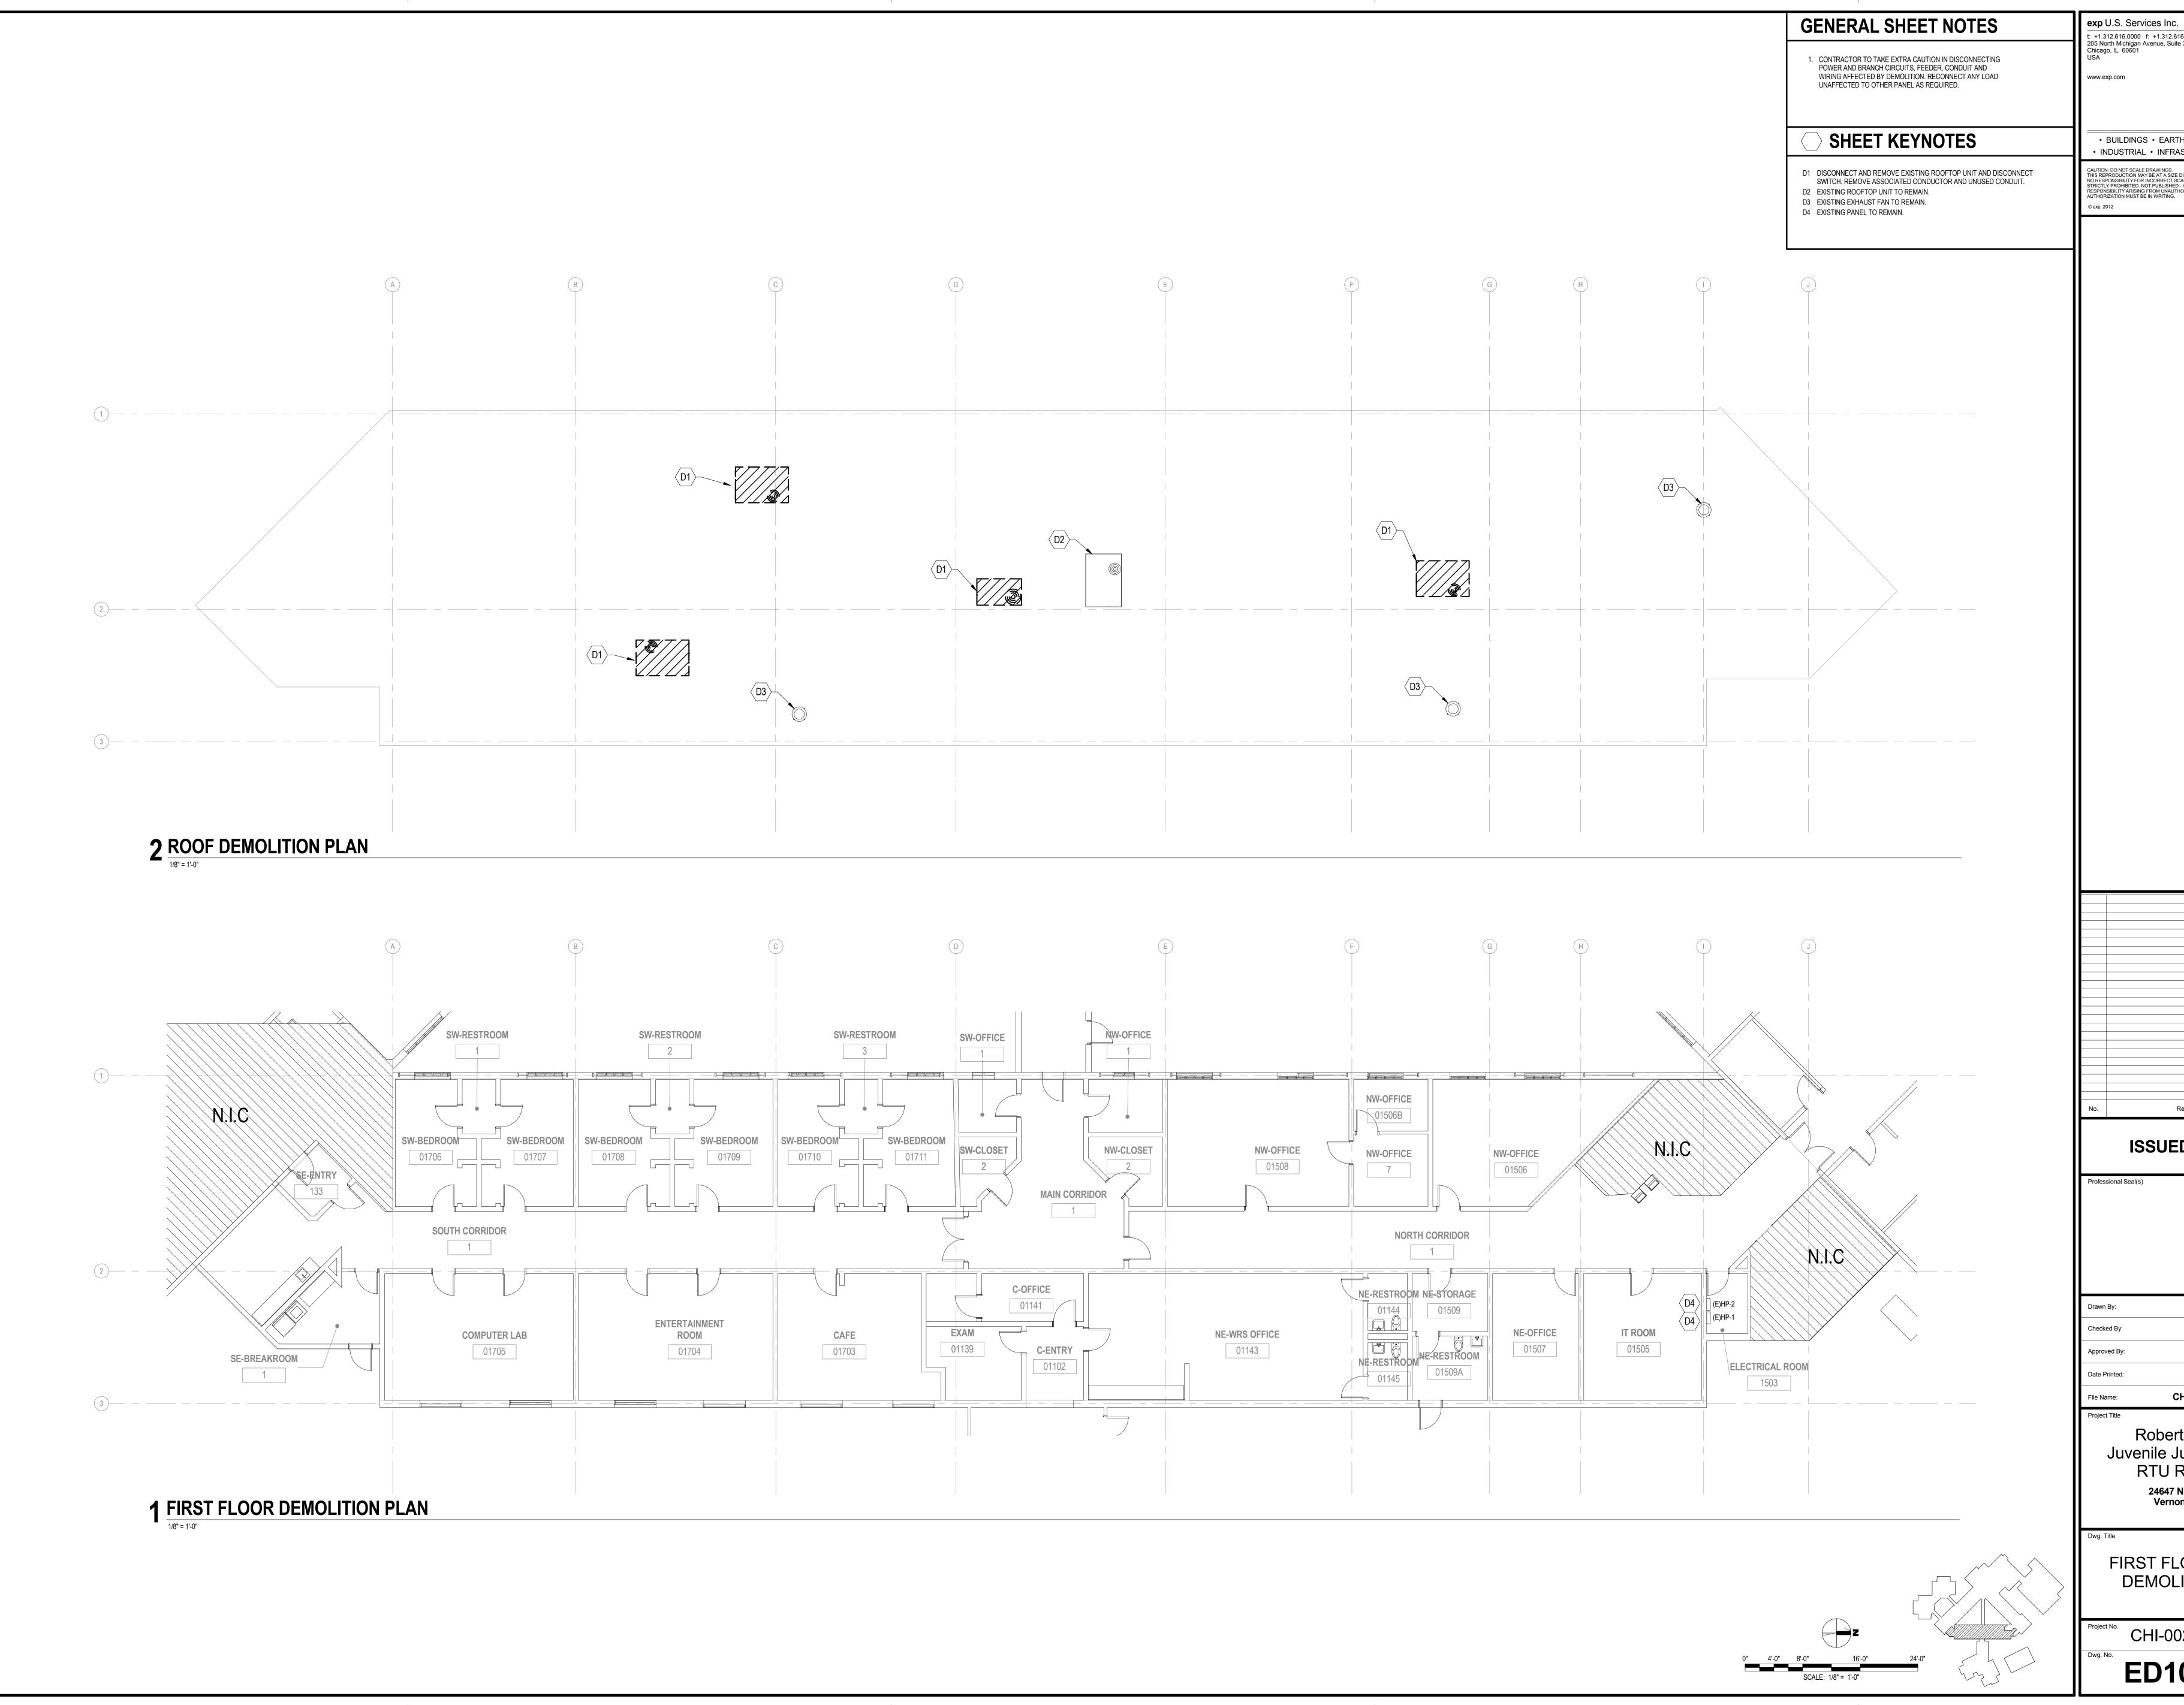

	BUILDINGS • EARTH & ENVIRONMENT • EI IDUSTRIAL • INFRASTRUCTURE • SUSTAIN						
CAUTION: DO NOT SCALE DRAWINGS. THIS REPRODUCTION MAY BE AT A SIZE DIFFERENT THAN ORIGINALLY DRAWN. EXP ASSUMES NO RESPONSIBILITY FOR INCORRECT SCALING. UNAUTHORIZED REPRODUCTION OR REUSE IS STRICTLY PROHIBITED. NOT PUBLISHED - ALL RIGHTS RESERVED. EXP EXPRESSLY DISCLAIMS RESPONSIBILITY ARISING FROM UNAUTHORIZED USE OF THESE DRAWINGS AND NOTES. AUTHORIZATION MUST BE IN WRITING.							
© exp, 2	012						
No.	Revision	Date					
	ISSUED FOR BID	Revision Date Revision Date Revisi					
Profes	ISSUED FOR BID Professional Seal(s) Professional Seal(s) Drawn By: HL Checked By: HO Approved By: JFR Date Printed: 06.18.2018 File Name: CHI-00240054-A1.rfa Project Title Robbert W. Depke JUVEnile JUSTICE COmplex RTU Replacement Z4647 N Milwaukee Ave, Vernon Hills, IL 60061 Project Title Project No. Project No. CHI-00240054-A1.						
Approv							
	t Title						
	Juvenile Justice Comp						
	24647 N Milwaukee Ave,						
שש. Twg. T		R					
Projec							
Dwg. 1	lo. Rev.	No.					
	ED101						

t: +1.312.616.0000 f: +1.312.616.6069 205 North Michigan Avenue, Suite 3600 Chicago, IL 60601 USA

www.exp.com

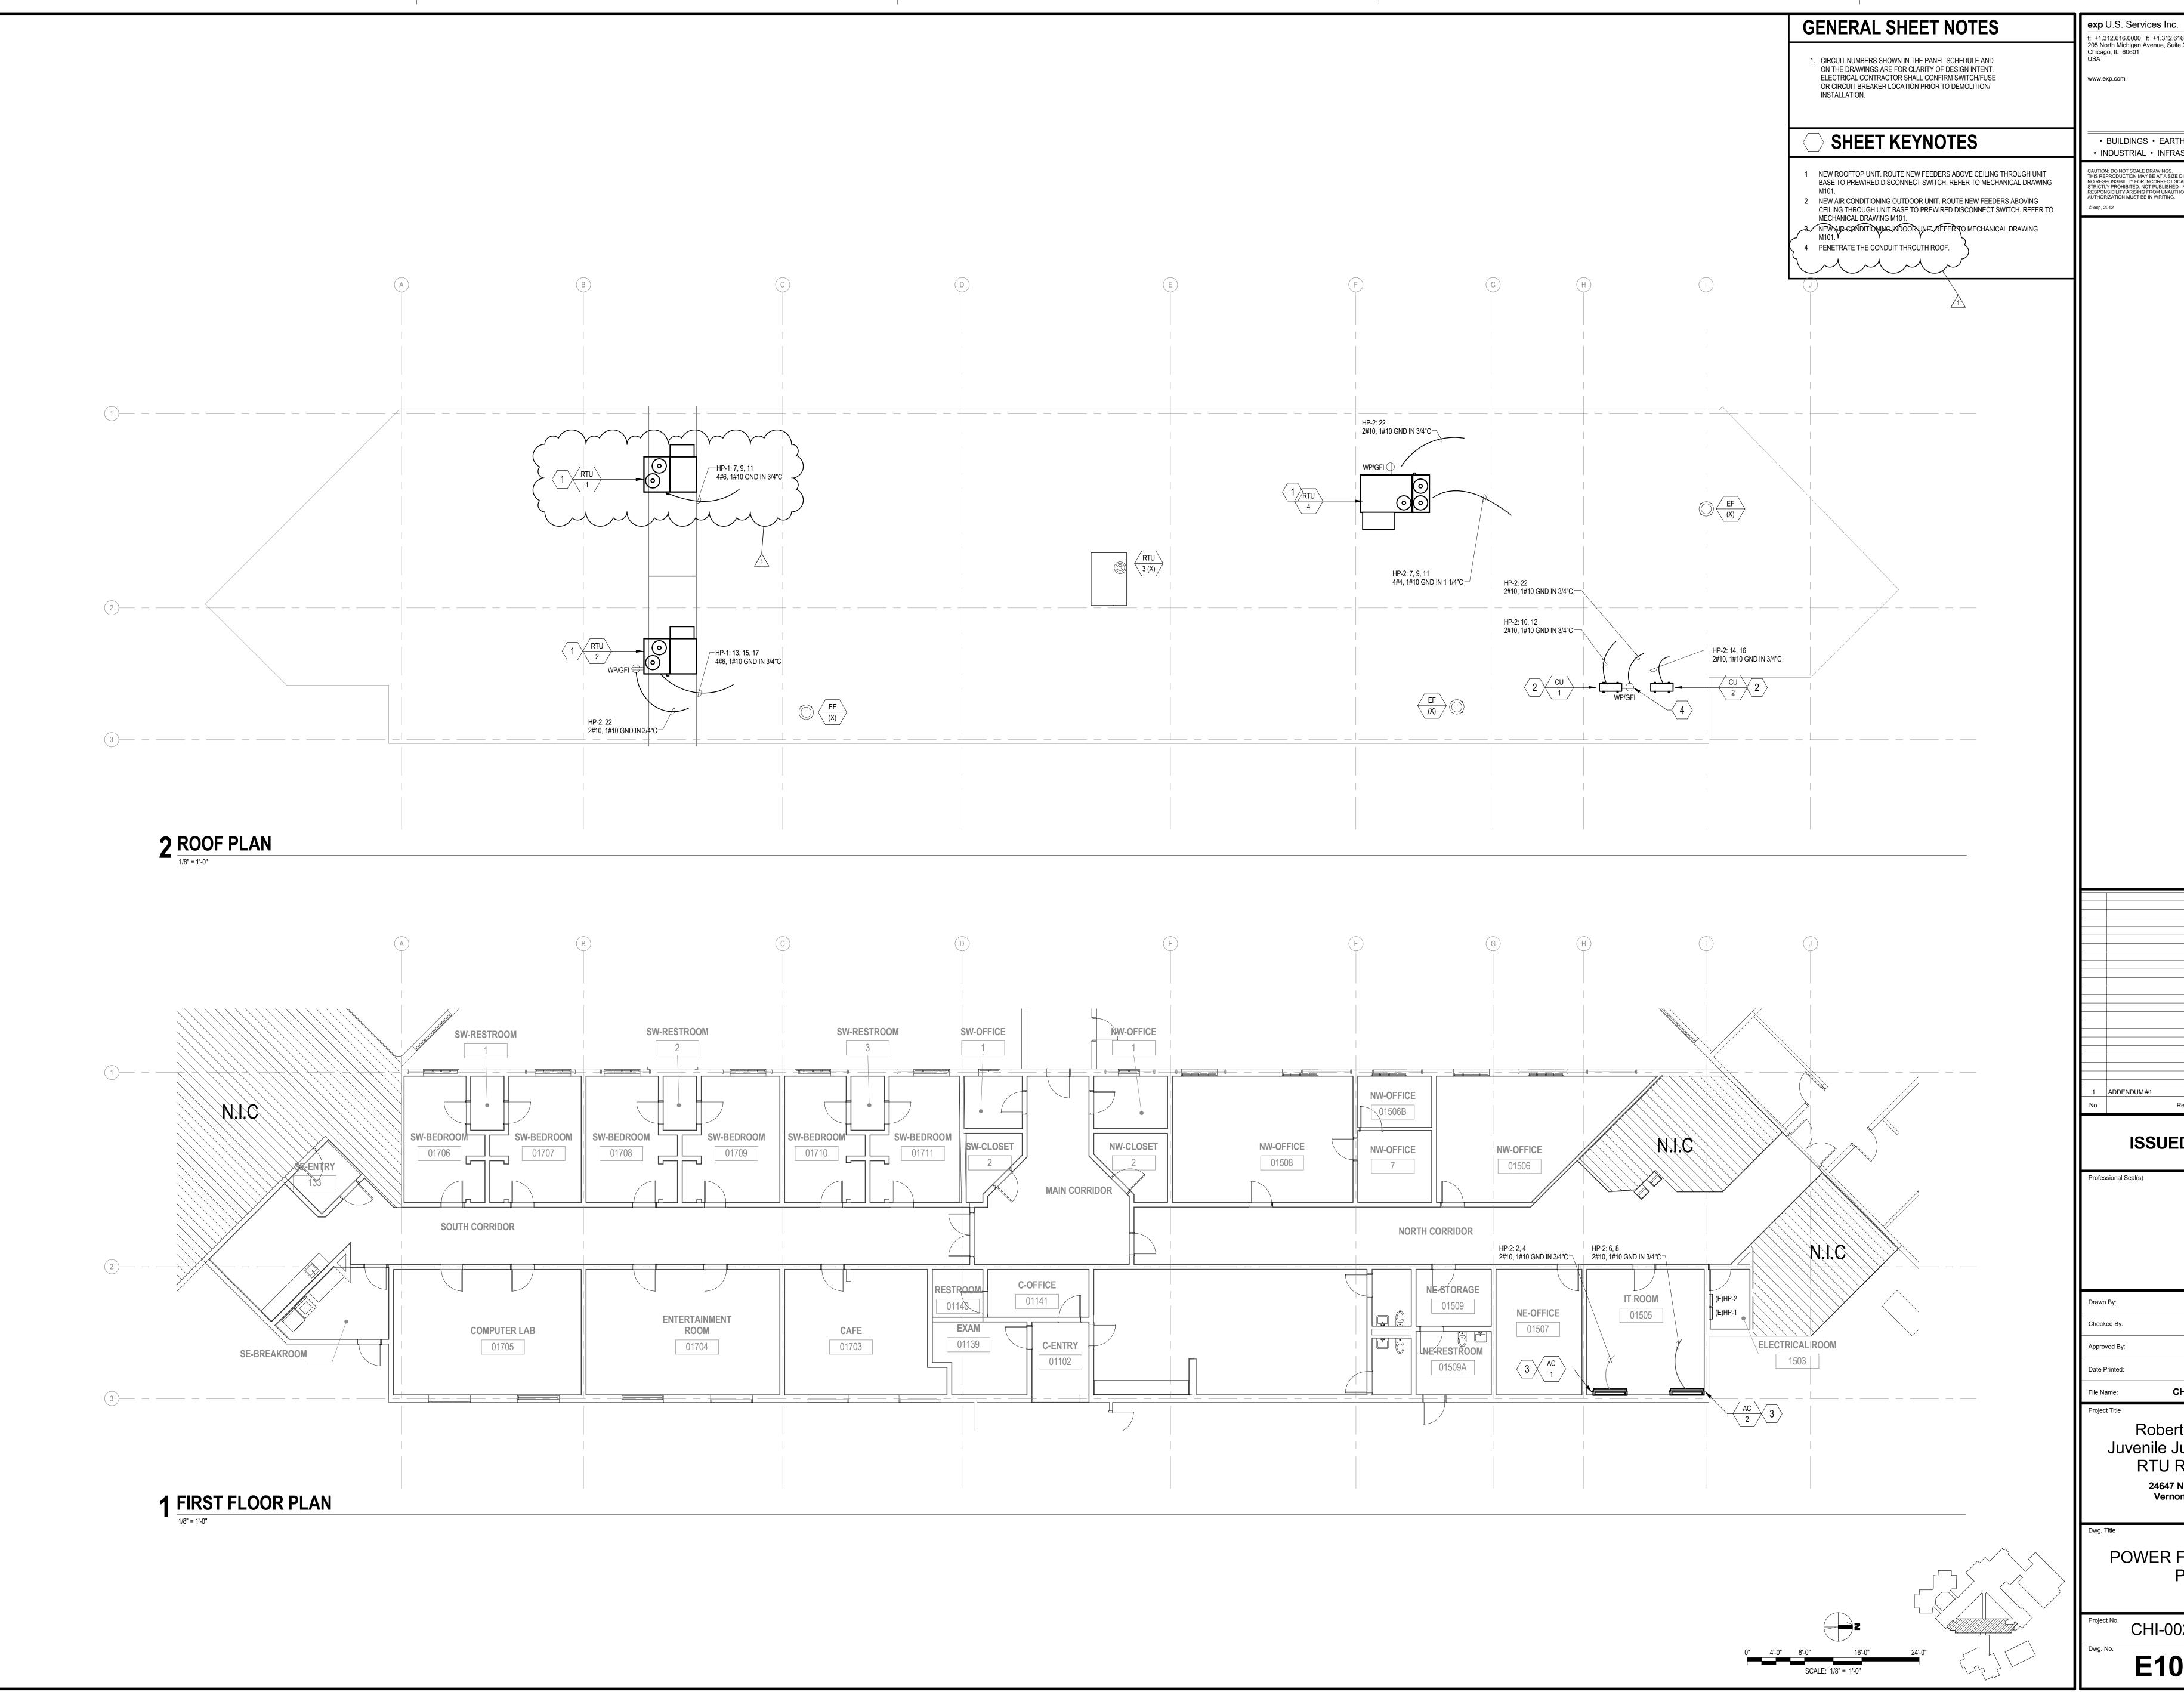

BUILDINGS • EARTH & ENVIRONMENT • E INDUSTRIAL • INFRASTRUCTURE • SUSTAI	
CAUTION: DO NOT SCALE DRAWINGS. THIS REPRODUCTION MAY BE AT A SIZE DIFFERENT THAN ORIGINALLY DRAWN NO RESPONSIBILITY FOR INCORRECT SCALING. UNAUTHORIZED REPRODUCTI STRICTLY PROHIBITED. NOT PUBLISHED - ALL RIGHTS RESERVED. EXP EXPRES RESPONSIBILITY ARISING FROM UNAUTHORIZED USE OF THESE DRAWINGS AN AUTHORIZATION MUST BE IN WRITING.	ON OR REUSE IS SSLY DISCLAIMS
© exp, 2012	
1 ADDENDUM #1	06-29-2018
No. Revision	Date
Professional Seal(s)	
Juvenile Justice Comp	
24647 N Milwaukee Ave,	Ľ
POWER FIRST FLOC)R
PLAN	
5	. No.
E101	1


t: +1.312.616.0000 f: +1.312.616.6069 205 North Michigan Avenue, Suite 3600 Chicago, IL 60601 USA


www.exp.com

	PANEL NAME		LOCATION		М	OUN	NTING		SU	PPLI	ED FR	ОМ		V
	(E)HP-1	ELEC	CTRICAL RC	MOC	S	SURF	FACE							1
CKT NO LOAD DESCRIPTION 1 3			VA LOAD		СВ							CE	3	
NO	LOAD DESCRIPTION	PH A	PH B	PH C	CODE	Р	TR	Α	В	С	TR	Р	CODE	P
	(E)HP-1 LOAD DESCRIPTION EXISTING (E)RT-1 (E)RT-2 SPACE EXISTING (E)RT-3 LOAD DESCRIPTION HTING CEPT (FIRST 10 KW) CEPT (REMAINDER) TORS GEST MOTOR JIPMENT ATING							X			30	2		
3	EXISTING					3	100		Х			2		
5										Х	30	2		
7		4407						X						
9	(E)HP-1 LOAD DESCRIPTION EXISTING (E)RT-1 (E)RT-2 (E)RT-2 SPACE EXISTING (E)RT-3 LOAD DESCRIPTION ITING EPT (FIRST 10 KW) EPT (REMAINDER) ORS GEST MOTOR IPMENT TING AL		4407			3	50		Х		30	2		-
11				4407						Х				
13		4407	4 4 9 7					X			30	2		
15	(E)RT-2	l	4407	4.407		3	50		X	v				-
17				4407		4		v		Х	30	2		
19 21	SPACE		PH B PH			1		X	х					
21	EXISTING					2	30		^	х	30	2		-
25		1585					x		~					
27		1000	1585			3	30		х		30	2		
29	(L)((1-5	l		1585					7	х		1		1
		СО			DEI	MAN	ID	1 ;	SUBF		OADS			
	LOAD DESCRIPTION		(KVA)	D.F.		(K	(VA)				(KVA)		CONN	ECTE
LIGH	FING		0.0	1.00			0.0	LIG	HTING	3	0.0		PHA	
RECE	PT (FIRST 10 KW)		0.0	1.00			0.0	REC	EPT		0.0		PH B	
RECE	PT (REMAINDER)		0.0	0.50			0.0	MO	TORS		0.0		PH C	
MOTO	DRS		0.0	1.00			0.0	EQU	JIP		0.0			
LARG	EST MOTOR		0.0	1.25			0.0	HEA	TING	i	0.0		TOTAL	-
EQUI	PMENT		0.0	1.00			0.0	TRA	NSF	ИR	0.0		CONN	ECTE
HEAT				1.00			0.0						DEMA	
TOTA	L		0.0				0.0						DESIG	N
							1000							
	GROUND BUS						100%	6 NEL	JIRAI	_ BOS	>			
	IGHITNG ECEPTACLE	M - Moto LM - Larg	RS EST MOTO	R	E - EQ H - HE	-					BFED BFED			SM SE

PANEL NAME		I		MOUNTING SUPPLIED FROM							M	VOLTAGE			BUS	MAIN			
	(E)HP-2	ELEC	TRICAL RO	MOO	S	SURF	ACE							120/208			400A		
СКТ			VA LOAD			СВ			BUS			СВ			VA LOAD				СКТ
NO	LOAD DESCRIPTION	PH A	PH B	PH C	CODE	Р	TR	Α	B (c -	TR	Ρ	CODE	PH A	PH B	PH C	LOAD DESCRIPTION		NO
1		9606.83	1		Е			х			30	2					SPARE		2
	EXISTING		9606.83			3	100					_					017112		4
				9606.83	E	4		v)	X	30	2			, l		SPARE		6
	SPACE			-		1	20	•	v										8 10
5 7 9 11 13 15 17 19 21 23 25	SPARE					2	70			x	30	2					SPARE		10 12
13	EXISTING	5824			Е	2	70	X			30	2					SDADE		14
15	EXISTING		5824		E	2	70		Х		30	2					_		16
Image: cmark cmark			18																
		1664		-				X			20	1	E	1920			EXISTING		20
		[1920					-			30	2					SPARE		22
				1920)	× _		_	_		, [24
	EXISTING	1920	4004	-		1	20	X	X					3842.73	0040 70				26
	EXISTING		1664	1664		2	20				40	3			3842.73	2010 72	-		28 30
25				1004		MAN	D	Ģ					L.		. l	5042.75			00
	LOAD DESCRIPTION			D.F.									CONNE	CTED		VA			
LIGH	TING		. ,	1.00				LIGH	ITING		,		PH A			24,778			
RECE	EPT (FIRST 10 KW)		0.0	1.00			0.0	REC	EPT	(0.0		PH B			22,858			
RECE	EPT (REMAINDER)		0.0	0.50			0.0	мот	ORS	(0.0		PH C			20,618			
MOTO	ORS		0.0	1.00			0.0	EQU	IP	(0.0								
			0.0	1.25			0.0	HEA	TING	(0.0		TOTAL			KVA		AMPS	
								TRAI	NSFMR	. (0.0							189.5	
17EXISTING19EXISTING21EXISTING23EXISTING25EXISTING27EXISTING29EXISTING29LOAD DESCRIPTIONLIGHTINGRECEPT (FIRST 10 KW)RECEPT (FIRST 10 KW)RECEPT (REMAINDER)MOTORSLARGEST MOTOREQUIPMENTHEATINGTOTALGROUND BUSLL<				1.00												68.3		189.5	
ΤΟΤΑ	L		68.3				68.3						DESIGN	N					
GROUND BUS 100% NE				NEU	NEUTRAL BUS							ISC =							
																	SH - SUBFED HEATING		

PANEL NOTES: EXISTING LOADS ARE BASED ON 80% OF BREAKERS AMPS.

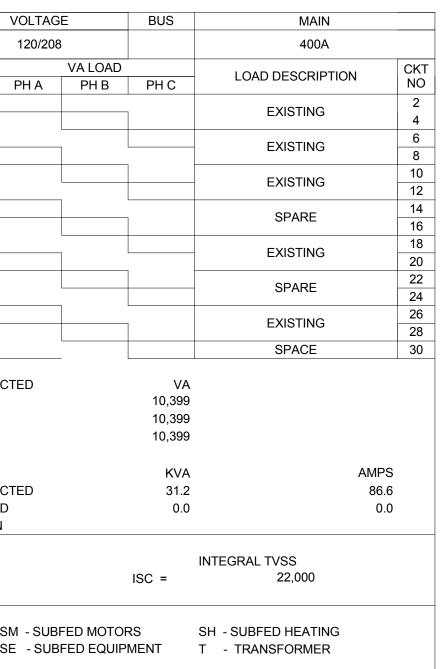

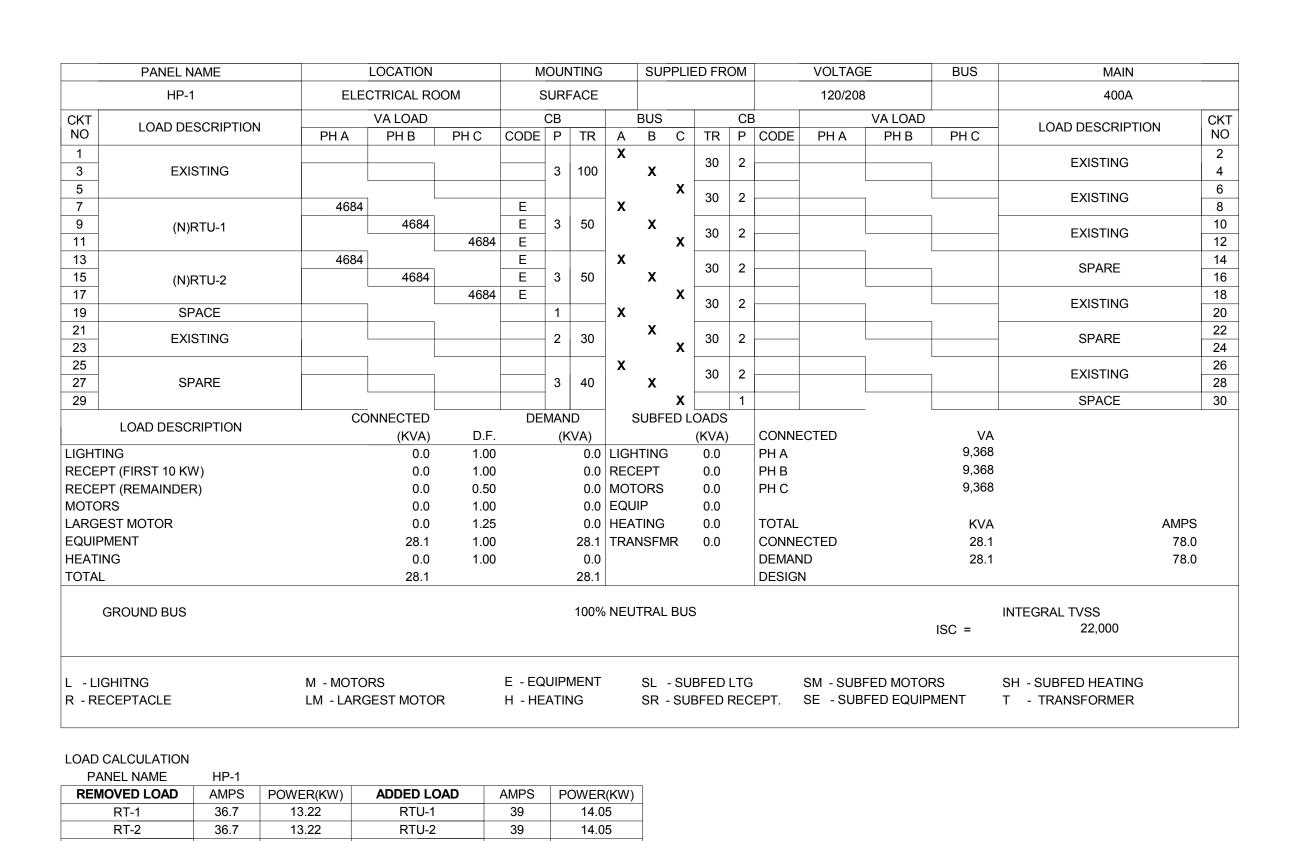

28.10

	PANEL NAME		LOCATION		MOUNTING			SUPPLIED F		ED FF	
HP-2		ELECTRICAL ROOM		SURFACE							
CKT LOAD DESCRIPTION		VA LOAD		СВ				BUS			
NO	LOAD DESCRIPTION	PH A	PH B	PH C	CODE	Р	TR	Α	В	С	TR
1		9607			E			Х			20
3	EXISTING		9607	0007	E	3	100		Х	X X	
5 7		5764	L	9607	E			x			20
9	(N)RTU-4	0704	5764		E	3	60		х		
11		L		5764	Е					Х	30
13	EXISTING	5824			Е	2	70	X			30
15	EXISTING		5824		E	2	10		Х		
17	EXISTING			1664	E	2	20			Х	20
19 21	EXISTING	1664	1000		E	4		X	х		20
21	EXISTING	L	1920	1920	E	1	20 20	_	X	х	20 20
25	EXISTING	1920		1920	E	1	20	x		~	20
27			1664		E				Х		40
29	EXISTING			1664	E	2	20			Х	
	LOAD DESCRIPTION	CO	NNECTED		DE	MAN	İD		SUBFI	ED L	OAD
			(KVA)	D.F.		(K	(VA)				(KVA
LIGHTI			0.0	1.00					HTING	i	0.0
	PT (FIRST 10 KW)		0.5	1.00				REC			0.0
MOTOF	PT (REMAINDER)		0.0 0.0	0.50 1.00				EQL			0.0 0.0
	ST MOTOR		0.0	1.00							0.0
EQUIP			94.3	1.00					NSFM	1R	0.0
HEATIN			0.0	1.00			0.0				
TOTAL			94.8				94.8				
C	GROUND BUS						100%	5 NEL	JTRAL	BUS	8
L - LIG R - RE	GHITNG CEPTACLE	M - MOTOF LM - LARG		R	E - EQ H - HE				SL SR ·		BFED

13.22

31.20

RTU-2

TOTAL

36.7

-3.10 KW

13.2 4.76

RT-2

RT-3 TOTAL

NET LOAD

PANEL NOTES: EXISTING LOADS ARE BASED ON 80% OF BREAKERS AMPS.

GENERAL SHEET NOTES

exp U.S. Services Inc.


www.exp.com

t: +1.312.616.0000 f: +1.312.616.6069 205 North Michigan Avenue, Suite 3600 Chicago, IL 60601 USA

1. CIRCUIT NUMBERS SHOWN IN THE PANEL SCHEDULE AND ON THE DRAWINGS ARE FOR CLARITY OF DESIGN INTENT. ELECTRICAL CONTRACTOR SHALL CONFIRM SWITCH/FUSE OR CIRCUIT BREAKER LOCATION PRIOR TO DEMOLITION/ INSTALLATION.

SHEET KEYNOTES

- 1 DISCONNECT AND REMOVE EXISTING CIRCUIT BREAKER.
- 2 PROVIDE NEW 60A, 3P BREAKER MATCH EXISTING PANEL MANUFACTURER AND STYLE.
- 3 PROVIDE NEW 20A, 3P BREAKER MATCH EXISTING PANEL MANUFACTURER AND STYLE.

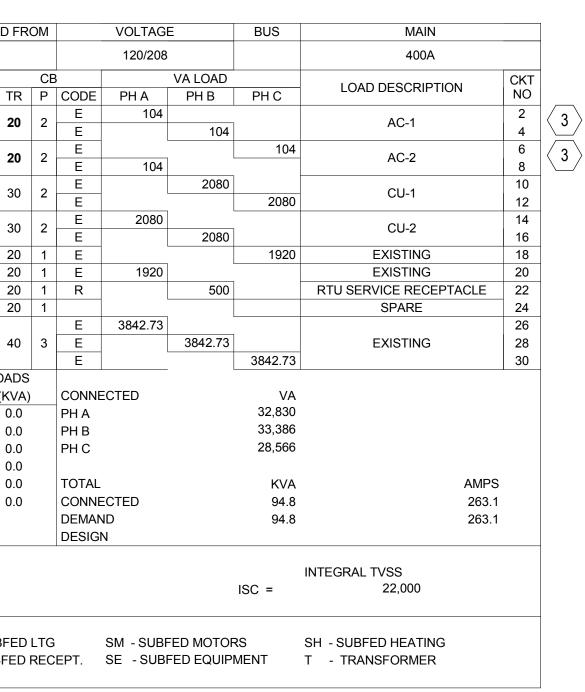

	BUILDINGS • EARTH & ENVIRONMENT • EN IDUSTRIAL • INFRASTRUCTURE • SUSTAIN	
THIS REI NO RESI STRICTL RESPON	A: DO NOT SCALE DRAWINGS. PRODUCTION MAY BE AT A SIZE DIFFERENT THAN ORIGINALLY DRAWN. PONSIBILITY FOR INCORRECT SCALING. UNAUTHORIZED REPRODUCTION PROHIBITED. NOT PUBLISHED - ALL RIGHTS RESERVED. EXP EXPRESS ISIBILITY ARISING FROM UNAUTHORIZED USE OF THESE DRAWINGS AND IZATION MUST BE IN WRITING. D12	I OR REUSE IS LY DISCLAIMS
No.	Revision	Date
	ISSUED FOR BID	
Profes	sional Seal(s)	
Drawn	By: HL	
Check Approv	ed By: HO ved By: JFR	
Date F		
File Na Projec	t Title	
	Robert W. Depke Juvenile Justice Compl RTU Replacement	ex
	24647 N Milwaukee Ave, Vernon Hills, IL 60061	
Dwg. 1	īitle	
	ELECTRICAL SCHEDULES	
Projec	CHI-00240054-A1	No
Dwg. N	E601	NO.

GENERAL

RELATED DOCUMENTS

- THE GENERAL REQUIREMENTS OF THE ARCHITECTURAL SPECIFICATIONS ARE PART
- WORDING OR INTENT. THIS SECTION SHALL TAKE PRECEDENCE FOR THE MECHANCIAL AND ELECTRICAL SCOPE. THE STANDARD FORM OF "GENERAL
- CONDITIONS" ISSUED BY THE AMERICAN INSTITUTE OF ARCHITECTS DOCUMENT A201, LATEST EDITION, SHALL FORM PART OF THIS CONTRACT.
- CONTRACT DOCUMENTS MAY INCLUDE, BUT NOT LIMITED TO THE FOLLOWING: 2. ARCHITECTURAL, STRUCTURAL, ELECTRICAL, MECHANICAL, FIRE PROTECTION, AND CIVII

DEFINITIONS

- "FURNISH" MEANS TO SUPPLY AND DELIVER OF AN ITEM OF EQUIPMENT TO THE PROJECT SITE READY FOR INSTALLATION
- "INSTALL" MEANS TO SET IN PLACE, CONNECT AND PLACE IN FULL OPERATIONAL ORDER. "PROVIDE" MEANS TO "FURNISH" AND "INSTALL".
- "EQUIVALENT" MEANS TO MEET THE SPECIFICATIONS OF THE REFERENCED PRODUCT OR
- ITEM ON ALL SIGNIFICANT ASPECTS, WHERE SIGNIFICANT ASPECTS SHALL BE DETERMINED BY THE ENGINEER.
- "FUTURE", "REFER (DISCIPLINE) DIVISION" AND SIMILAR EXPRESSIONS INDICATE WORK THAT MAY BE PERFORMED UNDER THE CONTRACT DOCUMENTS BUT, NOT NECESSARILY UNDER THE DIVISION OR DISCIPLINE ON WHICH THE NOTE APPEARS. THE CONTRACTOR SHALL BE RESPONSIBLE FOR COORDINATING THE WORK WITH SUPPLIERS,
- <u>SUBMITTALS</u>

CONTRACTOR SHALL SUBMIT FOR REVIEW TO THE ARCHITECT/ENGINEER A COMPLETE LIST OF ITEMS TO BE FURNISHED AND INSTALLED UNDER THIS CONTRACT. INCLUDING, BUT NOT BE LIMITED TO THE FOLLOWING:

- DIMENSIONED SHOP DRAWINGS OF MATERIALS, AND EQUIPMENT. DIMENSIONED SHOP DRAWINGS OF EQUIPMENT AND PIPING PLAN LAYOUT(S) PRODUCT DATA.
- FIELD-QUALITY CONTROL INSPECTION AND TEST REPORTS FIELD TEST CERTIFICATES. OPERATION AND MAINTENANCE DATA.

EQUIPMENT MANUALS.

QUALITY ASSURANCE

FIRE TEST RESPONSE CHARACTERISTICS: INSULATION AND RELATED MATERIALS SHALL HAVE FIRE TEST RESPONSE CHARACTERISTICS INDICATED, AS DETERMINED BY TESTING IDENTICAL PRODUCTS PER ASTM E 84, BY A TESTING AND INSPECTING AGENCY ACCEPTABLE TO

OF APPLICABLE TESTING AND INSPECTING AGENCY.

INSULATION INSTALLED INDOORS: FLAME SPREAD INDEX OF 25 OR LESS, AND SMOKE DEVELOPED INDEX OF 50 OR LESS INSULATION INSTALLED OUTDOORS: FLAME SPREAD INDEX OF 75 OR LESS, AND SMOKE DEVELOPED INDEX OF 150 OR LESS.

CONTRACT DOCUMENTS

- CONTRACTOR SHALL REVIEW CONTRACT DOCUMENTS AND BECOME FAMILIAR WITH THE SITE AND LOCAL CONDITIONS RELATING TO WORK AS DESCRIBED HEREIN PRIOR TO SUBMITTING BID PROPOSAL. FAILURE TO DO SO SHALL NOT RELIEVE CONTRACTOR
- ARCHITECT / ENGINEER IN WRITING
- EQUIPMENT. THE LAYOUT OF THE SYSTEM(S) EQUIPMENT, ACCESSORIES AND OTHER COMPONENTS ARE DIAGRAMMATIC UNLESS SPECIFICALLY SHOWN OR DIMENSIONED.
- CONTRACTOR SHALL BID ALL WORK AS SHOWN. AND MATERIAL AND EQUIPMENT AS SPECIFIED HEREIN. ANY SUBSTITUTION (NOT APPROVED) DURING THE BIDDING
- CONTRACTOR SHALL BE FINANCIALLY LIABLE FOR ANY REQUIRED ENGINEERING REVIEW DUE TO ANY PROPOSED PRODUCT CHANGE AND/OR VOLUNTARY "VALUE
- ENGINEERING" DURING THE BIDDING PROCEDURE AND THE SUBMITTAL PROCESS. ANY CONFLICTING INFORMATION DEPICTED OR IMPLIED ON THE DRAWINGS IDENTIFIED DURING THE BIDDING PROCESS SHALL BE SUBMITTED FOR CLARIFICATION OF INTENT.
- LIABLE FOR ANY ASSOCIATED COSTS RELATIVE TO CHANGES DURING THE CONSTRUCTION PROCESS.

SPECIFICATIONS AND DRAWINGS

SPECIFICATIONS AND DRAWINGS ARE INTENDED TO BE COOPERATIVE. WHAT IS CALLED FOR BY EITHER SHALL BE AS BINDING AS IF CALLED FOR BY BOTH. ANY WORK

VISITING THE SITE

- BECOME FAMILIAR WITH THE SITE AND EXISTING CONDITIONS FOR DOING WORK AS SHOWN ON DRAWINGS AND SPECIFIED HEREIN. FAILURE TO COMPLY SHALL NOT RELIEVE THE CONTRACTOR OF THE OBLIGATIONS OF THE CONTRACT.

ARCHITECT/ENGINEER, IN WRITING.

- PERMITS, FEES & INSPECTIONS
- CONTRACTOR SHALL PREPARE AND SUBMIT ALL DATA. DRAWINGS AND DETAILS REQUIRED, SECURE AND PAY FOR ALL PERMITS, GOVERNMENTAL FEES, TAXES,
- INSPECTIONS AND LICENSES NECESSARY FOR THE PROPER EXECUTION AND COMPLETION OF THE WORK.
- COUNTY SHALL PAY FOR ALL APPLICABLE FEES FOR TEST AND INSPECTIONS REQUIRED BY LOCAL AUTHORITIES HAVING JURISDICTION.
- REGULATIONS IS MANDATORY AND ANY COSTS INVOLVED SHALL BE INCLUDED IN THE CONTRACT.

LAWS AND ORDINANCES

- CONTRACTOR SHALL GIVE ALL NOTICES AND COMPLY WITH ALL LAWS, ORDINANCES, RULES AND REGULATIONS BEARING ON THE CONDUCT OF WORK AS SHOWN ON DRAWINGS AND SPECIFIED HEREIN. IF CONTRACTOR OBSERVES THAT THE DRAWINGS AND SPECIFICATIONS ARE AT VARIANCE THEREWITH, CONTRACTOR SHALL PROMPTLY NOTIFY ARCHITECT/ENGINEER IN WRITING WHEN SUBMITTING BID AND ANY NECESSARY
- CHANGES SHALL BE ADJUSTED AS PROVIDED IN THE CONTRACT FOR SUCH CHANGES IN WORK. IF CONTRACTOR PERFORMS ANY WORK, CONTRARY TO SUCH LAWS, ORDINANCES, RULES AND REGULATIONS, CONTRACTOR SHALL BEAR ALL COSTS FOR CORRECTING THE WORK.

TRADE JURISDICTION

WHEN IT BECOMES NECESSARY FOR THE COMPLETE FULFILLMENT OF THIS WORK FOR THIS CONTRACTOR TO FURNISH LABOR OR MATERIALS OTHER THAN THAT WHICH IS GENERALLY ACCEPTED BY THIS TRADE OR BRANCH OF WORK, THE CONTRACTOR SHALL SUBLET SAME TO A CONTRACTOR ENGAGED IN THE TRADE OR BRANCH OF WORK INVOLVED. THERE SHALL BE NO DELAY TO OR STOPPAGE OF WORK DUE TO THE INFRINGEMENT OR ALLEGED INFRINGEMENT TO TRADE AGREEMENTS AS TO THE JURISDICTION.

REQUESTS FOR INFORMATION (RFI'S)

- ALL REQUESTS FOR INFORMATION (RFI'S) SHALL BE SUBMITTED IN WRITING TO THE GENERAL CONTRACTOR OR CONSTRUCTION MANAGER.
- IF THERE IS NO CONSTRUCTION MANAGER OR GENERAL CONTRACTOR. SUBMIT RFI'S TO THE ARCHITECT/ENGINEER.
- THERE WILL BE NO RESPONSE TO RFI'S THAT ARE NOT SUBMITTED IN WRITTEN FORM.
- ANY FORMAL OR INFORMAL, OR PHONE CONVERSATION DO NOT CONSTITUTE THE AUTHORIZATION TO PROCEED.

WORKMANSHIP

ALL LABOR SHALL BE EXECUTED IN A NEAT, WORKMANLIKE MANNER AND SHALL BE PERFORMED BY PERSONS SKILLED IN THEIR RESPECTIVE TRADES. THE ENGINEER/OWNER SHALL DECIDE ALL MATTERS PERTAINING TO THE QUALITY OF WORKMANSHIP AND MATERIALS.

- **COORDINATION OF WORK**
 - OPERATIONS TEAM, ETC. TO AVOID INTERFERENCE BEFORE STARTING ANY INSTALLATION. ANY NEGLECT BY THE CONTRACTOR TO COORDINATE WITH OTHER CONSTRUCTION SHALL BE MADE AT THE CONTRACTOR'S OWN EXPENSE.

OPERATIONAL SYSTEMS OR SPACES.

- **CUTTING AND PATCHING** CONTRACTOR SHALL INCLUDE ALL CUTTING AND PATCHING, AS REQUIRED. ALL CORFS/PENETRATIONS THROUGH ROOF OR THROUGH SLABS AND FOUNDATION WALLS SHALL BE APPROVED IN WRITING BY THE ARCHITECT/ENGINEER.
- APPROVED. PATCH ALL DISTURBED WALL, FLOORS, PARTITIONS, CEILINGS, ETC., RESTORE TO ORIGINAL CONDITION.

OPERATING INSTRUCTIONS

CONTRACTOR SHALL PREPARE A WRITTEN LIST IN DUPLICATE, OF INSTRUCTIONS OF THE OPERATION OF ALL EQUIPMENT AND SHALL INSTRUCT IN ITS OPERATION. ALL DAMPERS AND EQUIPMENT SHALL BE MARKED WITH A METAL TAG AND A TYPEWRITTEN SCHEDULE SHALL BE GIVEN TO THE OWNER.

GUARANTEE

CONTRACTOR SHALL GUARANTEE WORK TO BE FREE FROM DEFECTIVE WORKMANSHIP AND MATERIALS FOR A PERIOD OF ONE (1) YEAR FROM DATE OF FINAL CERTIFICATE. ANY REPAIRS OR REPLACEMENT DURING THIS PERIOD SHALL BE MADE WITHOUT COST TO THE OWNER, UPON OWNER'S REQUEST.

SPECIFICATIONS

ALL MATERIALS SHALL BE NEW AND OF FIRST CLASS PRODUCTS OF MANUFACTURERS

OF THESE SPECIFICATIONS. WHERE AN INCONSISTENCY EXISTS BETWEEN THE

SUBCONTRACTORS, EMPLOYEES, ETC. SHOULD CLARIFICATION OF ANY PORTION OF THE WORK BE REQUIRED. CONTACT THE ARCHITECT/ENGINEER PRIOR TO SUBMITTING BID.

AUTHORITIES HAVING JURISDICTION. FACTORY LABEL INSULATION AND JACKET MATERIALS AND ADHESIVE, MASTIC, AND CEMENT MATERIAL CONTAINERS, WITH APPROPRIATE MARKINGS

OF THE OBLIGATIONS OF THE CONTRACT. IDENTIFY ALL DISCREPANCIES AND NOTIFY

THE DRAWINGS INDICATE THE GENERAL LAYOUT OF THE VARIOUS SYSTEM(S) AND

PROCESS TO SECURE AWARD OF THE CONTRACT WILL NOT BE ACKNOWLEDGED. FAILURE TO CLARIFY THE ARCHITECT/ENGINEER INTENT, MAY MAKE THE CONTRACTOR

OR MATERIALS NOT SPECIFICALLY MENTIONED THOUGH REQUIRED TO MAKE THE JOB COMPLETE, SHALL BE FURNISHED AT THE CONTRACTOR'S EXPENSE.

PRIOR TO SUBMITTING BID PROPOSAL, CONTRACTOR SHALL VISIT THE SITE AND CONTRACTOR SHALL IDENTIFY ALL DISCREPANCIES AND NOTIFY

WHERE REGULATIONS OF UTILITY COMPANIES APPLY, CONFORMANCE WITH THEIR

CONTRACTOR SHALL COORDINATE WITH ROOF CONSTRUCTION. OWNER'S

CONTRACTOR IS REQUIRED TO PROVIDE 48 HRS NOTICE OF ANY WORK THAT IMPACTS

CONTRACTOR SHALL ASSUME ALL LIABILITIES FOR CORES WHICH HAVE NOT BEEN

2.	SPECIFIED HEREIN AND OR AS APPROVED BY THE ARCHITECT/ENGINEER OF RECORD. THE DESIGN INTENT, SPACE REQUIREMENTS, PERFORMANCE, ETC., ARE BASED ON PRODUCTS OF THE MANUFACTURER(S) INDICATED IN THESE SPECIFICATIONS. UNLESS NOTED OTHERWISE COMPARABLE PRODUCTS OF OTHER MANUFACTURER(S) MAY BE SUBMITTED FOR REVIEW TO THE ARCHITECT/ENGINEER OF RECORD. PRODUCTS INSTALLED WITHOUT APPROVAL OF THE ARCHITECT/ENGINEER SHALL BE REPLACED AT THE CONTRACTOR'S EXPENSE.
REFRIG	ERANT PIPING
	FRIGERANT PIPING MATERIAL, INSTALLATION AND PIPING TO BE PER THE INDIVIDUAL ACTURER'S INSTRUCTIONS AND INDUSTRY ACCEPTED PRACTICES.
PERFO A. B. C.	RMANCE REQUIREMENTS - LINE TEST PRESSURE FOR REFRIGERANT R-410A: SUCTION LINES FOR AIR-CONDITIONING APPLICATIONS: 300 PSIG. SUCTION LINES FOR HEAT-PUMP APPLICATIONS: 535 PSIG. HOT-GAS AND LIQUID LINES: 535 PSIG.
COPPE A. B. C. D. E.	R TUBE AND FITTINGS: COPPER TUBE: [ASTM B 88, TYPE K OR L] [ASTM B 280, TYPE ACR]. WROUGHT-COPPER FITTINGS: ASME B16.22. WROUGHT-COPPER UNIONS: ASME B16.22. SOLDER FILLER METALS: ASTM B 32. USE 95-5 TIN ANTIMONY OR ALLOY HB SOLDER TO JOIN COPPER SOCKET FITTINGS ON COPPER PIPE. BRAZING FILLER METALS: AWS A5.8/A5.8M.
DUCTW	<u>/ORK</u>
METAL A.	DUCTS AND FITTINGS GENERAL FABRICATION REQUIREMENTS: COMPLY WITH SMACNA'S "HVAC DUCT CONSTRUCTION STANDARDS - METAL AND FLEXIBLE" BASED ON INDICATED STATIC- PRESSURE CLASS UNLESS OTHERWISE INDICATED.
SHEET A.	METAL MATERIALS GENERAL MATERIAL REQUIREMENTS: COMPLY WITH SMACNA'S "HVAC DUCT CONSTRUCTION STANDARDS - METAL AND FLEXIBLE" FOR ACCEPTABLE MATERIALS, MATERIAL THICKNESSES, AND DUCT CONSTRUCTION METHODS UNLESS OTHERWISE

INDICATED. SHEET METAL MATERIALS SHALL BE FREE OF PITTING, SEAM MARKS, ROLLER MARKS, STAINS, DISCOLORATIONS, AND OTHER IMPERFECTIONS. GALVANIZED SHEET STEEL: COMPLY WITH ASTM A 653/A 653M. GALVANIZED COATING DESIGNATION: G60 OR G90 FINISHES FOR SURFACES EXPOSED TO VIEW: MILL PHOSPHATIZED.

SEALANT AND GASKETS

GENERAL SEALANT AND GASKET REQUIREMENTS: SURFACE-BURNING CHARACTERISTICS FOR SEALANTS AND GASKETS SHALL BE A MAXIMUM FLAME-SPREAD INDEX OF 25 AND A MAXIMUM SMOKE-DEVELOPED INDEX OF 50 WHEN TESTED ACCORDING TO UL 723; CERTIFIED BY AN NRTI ALL DUCTWORK TO SEALED TO CLASS A

USE MASTIC TO SEAL ALL JOINTS AND SEAMS

HANGERS AND SUPPORTS HANGER RODS FOR NONCORROSIVE ENVIRONMENTS: CADMIUM-PLATED STEEL RODS AND NUTS. STRAP AND ROD SIZES: COMPLY WITH SMACNA'S "HVAC DUCT CONSTRUCTION STANDARDS - METAL AND FLEXIBLE," TABLE 5-1 "RECTANGULAR DUCT HANGERS MINIMUM SIZE," AND TABLE 5-2, "MINIMUM HANGER SIZES FOR ROUND DUCT."

- STEEL CABLES FOR GALVANIZED-STEEL DUCTS: GALVANIZED STEEL COMPLYING WITH ASTM A 603 STEEL CABLE END CONNECTIONS: CADMIUM-PLATED STEEL ASSEMBLIES WITH BRACKETS, SWIVEL, AND BOLTS DESIGNED FOR DUCT HANGER SERVICE; WITH AN
- AUTOMATIC-LOCKING AND CLAMPING DEVICE. DUCT ATTACHMENTS: SHEET METAL SCREWS, BLIND RIVETS, OR SELF-TAPPING METAL SCREWS; COMPATIBLE WITH DUCT MATERIALS.

FLEXIBLE DUCTS

PRODUCTS & MATERIALS

MATERIALS:

NON-INSULATED, FLEXIBLE DUCT: UL 181, CLASS 1, TWO-PLY VINYL FILM OR MULTIPLE LAYERS OF ALUMINUM LAMINATE SUPPORTED BY HELICALLY WOUND, SPRING-STEEL WIRE. PRESSURE RATING: 10-INCH WG POSITIVE AND 1.0-INCH WG NEGATIVE. MAYIMI IM AIR VELOCITY 4000 P

TEMPERATURE RANGE: MINUS 10 TO PLUS 160 DEG F. FLEXIBLE DUCTWORK TO BE NO LONGER THAN 5' MAXIMUM.

INSULATED, FLEXIBLE DUCT: UL 181, CLASS 1, TWO-PLY VINYL OR MULTIPLE LAYERS OF ALUMINUM LAMINATE FILM SUPPORTED BY HELICALLY WOUND, SPRING-STEEL WIRE; FIBROUS-GLASS INSULATION; POLYETHYLENE OR ALUMINIZED VAPOR-BARRIER FILM. PRESSURE RATING: 10-INCH WG POSITIVE AND 1.0-INCH WG NEGATIVE. MAXIMUM AIR VELOCITY: 4000 FPM. TEMPERATURE RANGE: MINUS 10 TO PLUS 160 DEG E.

INSULATION R-VALUE: COMPLY WITH ASHRAE/IES 90.1. FLEXIBLE DUCTWORK TO BE NO LONGER THAN 5' MAXIMUM.

DUCT INSULATION

INDOOR DUCTS AND PLENUMS CONCEALED, SUPPLY-AIR DUCT AND PLENUM INSULATION: MINERAL-FIBER BLANKET OR BOARD, 1-72, INDALES OR GREATER, THICK AND A-75-LB/OU-FT. NOMMALDENSITY-OUTDOOR DUCTS AND PLENUMS

ALL OUTDOOR EXPOSED DUCTWORK TO HAVE FIELD APPLIED JACKET INSTALLED OVER INSULATION AND FACTORY APPLIED JACKET AS REQUIRED. FIELD APPLIED JACKTED TO BE PAINTED ALUMINUM, SMOOTH: 0.024 INCH THICK. \sim \sim \sim \sim \sim

AIR TERMINAL DEVICES TO BE EITHER TITUS, NAILOR, PRICE OR METALAIRE. REFER TO DIFFUSER SCHEDULE FOR ADDITIONAL REQUIREMENTS. DAMPERS

MANUAL VOLUME DAMPERS

TYPE STANDARD, STEEL: STANDARD LEAKAGE RATING SUITABLE FOR HORIZONTAL OR VERTICAL APPLICATIONS.

FRAMES: FRAME: HAT-SHAPED, 0.094-INCH-THICK, GALVANIZED SHEET STEEL. Α. MITERED AND WELDED CORNERS.

FLANGES FOR ATTACHING TO WALLS AND FLANGELESS FRAMES FOR INSTALLING IN DUCTS. BLADES:

MULTIPLE OR SINGLE BLADE. PARALLEL- OR OPPOSED-BLADE DESIGN. STIFFEN DAMPER BLADES FOR STABILITY. GALVANIZED-STEEL, 0.064 INCH THICK.

BLADE AXLES: GALVANIZED STEEL. BEARINGS Α.

OIL-IMPREGNATED BRONZE, MOLDED SYNTHETICOR OIL-IMPREGNATED STAINLESS-STEEL DAMPERS IN DUCTS WITH PRESSURE CLASSES OF 3-INCH WG OR LESS SHALL HAVE AXLES FULL LENGTH OF DAMPER BLADES AND BEARINGS AT BOTH ENDS OF OPERATING SHAFT. TIE BARS AND BRACKETS: GALVANIZED STEEL.

FIRE DAMPERS

B.

Α.

В.

TYPE: STATIC STATIC OR DYNAMIC; RATED AND LABELED ACCORDING TO UL 555 BY AN CLOSING RATING IN DUCTS UP TO 4-INCH WG STATIC PRESSURE CLASS AND MINIMUM 2000-FPM VFI OCITY FIRE RATING: 1-1/2 OR 3 HOURS TO MATCH ASSEMBLY

FRAME: CURTAIN TYPE WITH BLADES OUTSIDE AIRSTREAM EXCEPT WHEN LOCATED BEHIND GRILLE WHERE BLADES MAY BE INSIDE AIRSTREAM; FABRICATED WITH ROLL-FORMED, 0.034-INCH-THICK GALVANIZED STEEL; WITH MITERED AND INTERLOCKING

CORNERS MOUNTING SLEEVE: FACTORY- OR FIELD-INSTALLED, GALVANIZED SHEET STEEL. MINIMUM THICKNESS: 0.05 0.138 INCH OR 0.39 INCH THICK, AS INDICATED, AND OF LENGTH TO SUIT APPLICATION EXCEPTION: OMIT SLEEVE WHERE DAMPER-FRAME WIDTH PERMITS DIRECT ATTACHMENT OF PERIMETER MOUNTING ANGLES ON EACH SIDE OF WALL OR FLOOR: THICKNESS OF DAMPER FRAME MUST COMPLY WITH SLEEVE

REQUIREMENTS. **ORIENTATION REQUIREMENTS:**

MOUNTING ORIENTATION: VERTICAL OR HORIZONTAL AS INDICATED. BLADES: ROLL-FORMED, INTERLOCKING, 0.024-INCH- OR 0.034-INCH- THICK, GALVANIZED SHEET STEEL. IN PLACE OF INTERLOCKING BLADES, USE FULL-LENGTH, 0.034-INCH-THICK,

GAI VANIZED-STEEL BLADE CONNECTORS. HORIZONTAL DAMPERS: INCLUDE BLADE LOCK AND STAINLESS-STEEL CLOSURE SPRING. HEAT-RESPONSIVE DEVICE: REPLACEABLE, 165 DEG F OR 212 DEG F RATED, FUSIBLE

HEAT-RESPONSIVE DEVICE: , RESETTABLE OR REPLACEABLE LINK AND SWITCH PACKAGE, FACTORY INSTALLED, 165 DEG F OR 212 DEG F RATED.

MECHANICAL EQUIPMENT

ALL MECHANICAL EQUIPMENT UNDER THIS SCOPE OF WORK TO BE PROVIDED AS INDICATED ON EQUIPMENT SCHEDULE SHEET M601. FIRESTOPPING:

CONTRACTOR SHALL BE RESPONSIBLE FOR FIRE STOPPING, FIRE CAULKING, FIRE DAMPERS AND INSTALLING ALL SYSTEMS WHERE MECHANICAL PIPING AND EQUIPMENT PENETRATE FIRE RATED SYSTEMS TO MAINTAIN THEIR EXISTING FIRE RATING, REFER TO EXISTING ARCHITECTURAL PLANS FOR LOCATIONS OF FIRE RATED WALLS. FLOORS AND STRUCTURES. MATERIAL SHALL STOP AND PREVENT FIRE AND SMOKE FROM PASSING/PENETRATING FIRE BARRIER.

EXECUTION SCOPE OF WORK FEDERAL LAWS HAVING JURISDICTION. TO THE OWNER. NOT LIMITED TO THE FOLLOWING: SUPPLY AIR EXHAUST AIR. RETURN AIR. CONTROLS SYSTEM MECHANICAL EQUIPMENT MECHANICAL SPECIALTIES SUBMITTALS AND SHOP DRAWINGS: DELAY ON THE PROJECT COPIES MINIMUM OF EACH. SHOP DRAWINGS SHALL INCLUDE CONTRACTOR'S NAME, JOB ADDRESS, ADJUSTED AND TESTED.

CLEANING, TESTS AND INSPECTIONS: AIR DISTRIBUTION SYSTEM CLEANING ALL EXISTING TO REMAIN AND NEW DUCTWORK AND EQUIPMENT TO BE CLEANED USING A SOURCE REMOVAL MECHANICAL CLEANING METHOD DESIGN TO SAFELY REMOVE CONTAMINANTS. CONTRACTOR TO VERIFY AGAOMST NADCA ACR. "VERIFICATION OF HVAC SYSTEM CLEANLINESS" SECTION. AND PREPARE WRITTEN CLEANLINESS VERIFICATION REPORT. HVAC TESTING, ADJUSTING AND BALANCING PRE AND POST TAB TO BE PROVIDED AS PART OF THIS SCOPE. PRE TEST TO NCLUDE AIRELOW TESTING OF ALL EXISTING AIR HANDLING LINITS, EXHAUST FAN AND DAMPER FUNCTIONALITY FOR EQUIPMENT LOCATED WITHIN THE SCOPE OF WORK. TEST TO ALSO INCLUDE THE IDENTIFICATION OF EXISTING AIRELOWS FOR ALL SUPPLY, RETURN AND EXHAUST DIFFUSERS. FINAL TAB OF AIRSIDE SYSTEM TO BE PERFORMED BY AN INDEPENDENT TEST AND BALANCE CONTRACTOR PER INDUSTRY STANDARDS. CONTRACTOR TO PROVIDE A PRETEST REPORT PRIOR TO THE DEMOLITION OF ANY EQUIPMENT FOR REVIEW BY OWNER/ENGINEER. FINAL TAB REPORT TO BE PROVIDED UPON COMPLETION OF WORK. INSPECTION ALL WORK COMPLETED UNDER THIS SCOPE TO BE SUBJECT TO FINAL INSPECTION PUNCH LIST BY OWNER AND/OR ENGINEER. RECORD DRAWING SUBMITTALS: AT PROJECT CLOSE-OUT. CONTRACTOR SHALL SUBMIT RECORD DRAWINGS

PROVIDE RECORD SUBMITTALS AS FOLLOWS: OWNER: 1 COPY. ARCHITECT OF RECORD: 1 COPY.

ENGINEER OF RECORD: 1 COPY. DRAWINGS

PROVIDE ALL LABOR, MATERIAL, EQUIPMENT, FACILITIES, TRANSPORTATION, FEES AND SERVICES NECESSARY FOR A COMPLETE MECHANICAL SYSTEM(S) AS INDICATED ON THE DRAWINGS AND SPECIFIED HEREIN. WORKMANSHIP SHALL BE COMPLETE IN EVERY ASPECT, TESTED, APPROVED AND SATISFACTORY TO THE ARCHITECT/ENGINEER/OWNER AND IN ACCORDANCE WITH LOCAL, STATE AND THE DRAWINGS INDICATE DIAGRAMMATICALLY THE EXTENT AND LOCATION OF THE WORK INCLUDED. WORK INDICATED, BUT HAVING MINOR DETAILS OBVIOUSLY OMITTED, SHALL BE PROVIDED, INCLUDING THESE DETAILS, WITHOUT EXTRA COST IT IS THE DECLARED AND ACKNOWLEDGED INTENT OF THESE SPECIFICATIONS TO PROVIDE A COMPLETE MECHANICAL SYSTEM(S). INCLUSIVE OF ALL REQUIRED PARTS AND ACCESSORIES COMPLETE AND READY FOR USE AS DESCRIBED, BUT

SHOP DRAWING LAYOUT SUBMITTAL(S) SHALL BE A MINIMUM OF 1/8 INCH PER FOOT SCALE, SHOWING ALL PIPING TO BE INSTALLED. DETAILED LAYOUT(S) OF EQUIPMENT ROOMS SHALL BE NOT LESS THAN 1/4 INCH PER FOOT SCALE. THE DRAWING SHALL ALSO SHOW THE WORK COORDINATED WITH ALL OTHER TRADES, ALL DRAWINGS SHALL BE SUBMITTED PRIOR TO STARTING ANY WORK, AND IN ACCORDANCE WITH AN APPROVED SCHEDULE, PROVIDED BY THE GENERAL CONTRACTOR, TO AVOID ANY EQUIPMENT, FIXTURES AND OTHER RELATED APPURTENANCES SHALL BE SUBMITTED IN BOUNDED BOOKLETS. ALL DATA MUST BE CLEARLY LEGIBLE. SUBMIT FOUR (4) CONTRACTOR SHALL SUBMIT TO GOVERNMENTAL AGENCIES AND UTILITY COMPANIES. SHOP DRAWINGS WHICH ARE REQUIRED BY THESE AGENCIES FOR THEIR APPROVAL. CONTRACTOR SHALL PREPARE AND FURNISH TO THE OWNER, TWO (2) BOUND BOOKLETS EACH CONTAINING A COMPLETE LIST OF ALL EQUIPMENT INSTALLED UNDER THIS CONTRACT. EACH PIECE OF EQUIPMENT LISTED SHALL ALSO BE DESCRIBED BY MANUFACTURER(S) MODEL NUMBER, FIGURE NUMBER AND THE COMPONENTS THEREIN WHICH MAKE UP THE PART(S) LIST. ELECTRONIC VERSION OF SHOP DRAWINGS MAY ALSO BE SUBMITTED TO THE ARCHITECT/ENGINEER IN PDF FORM VIA

MANUFACTURER'S NAME, CATALOG NUMBERS, CUTS, DIAGRAMS AND OTHER SUCH DESCRIPTIVE DATA AS REQUIRED TO IDENTIFY AND REVIEW THE EQUIPMENT. ONE (1) WEEK PRIOR TO FINAL INSPECTION, DELIVER TO THE ARCHITECT/ENGINEER/OWNER TYPEWRITTEN COPIES OF EACH OF THE FOLLOWING: CERTIFICATION FROM CONTRACTOR THAT ALL EQUIPMENT AND SYSTEM(S) HAVE BEEN PROPERLY INSTALLED, COMMISSIONED, ADJUSTED AND TESTED. CERTIFICATION FROM RESPECTIVE MANUFACTURER(S) AUTHORIZED REPRESENTATIVE THAT EQUIPMENT AND SYSTEM(S) HAVE BEEN PROPERLY INSTALLED, COMMISSIONED, CERTIFICATION FROM AUTHORITY HAVING JURISDICTION THAT ALL EQUIPMENT AND SYSTEM(S) HAVE BEEN PROPERLY INSTALLED, COMMISSIONED, ADJUSTED, TESTED AND ACCEPTED FROM THE AUTHORITY HAVING JURISDICTION.

(CERTIFIED OR APPROVED) ALSO KNOWN AS "AS-BUILT" DRAWINGS. LAYOUT SUBMITTALS SHALL BE SUBMITTED FOR RECORDS PRIOR TO FINAL ACCEPTANCE IN ELECTRONIC FORM ON COMPACT DISC(S), USING AUTOCAD VERSION 2013 "DWG" FORMAT OR ADOBE ACROBAT "PDF" FORMAT VIEWABLE FROM ADOBE. RECORD DATA EQUIPMENT, AND RELATED APPURTENANCES MAY BE SUBMITTED AS BOUND HARDCOPY OR ELECTRONIC ADOBE ACROBAT "PDF" FORMAT.

CONTRACTOR IS NOT ALLOWED TO USE THE CONTRACT DOCUMENTS FOR "AS-BUILT"

GENERAL NOTES

- . ALL PIPING, DUCTWORK OR MECHANICAL EQUIPMENT SHOWN IN LIGHT LINEWORK IS EXISTING AND TO REMAIN OR AS INDICATED BY KEYNOTES.
- 2. ALL PIPING, DUCTWORK OR MECHANICAL EQUIPMENT SHOWN IN DARK LINEWORK IS NEW OR AS INDICATED BY KEYNOTES. 3. ALL PIPING, DUCTWORK OR MECHANICAL EQUIPMENT SHOWN ON DEMOLITION DRAWINGS IN DASHED LINE WORK IS TO
- BE REMOVED OR AS INDICATED BY KEYNOTES AND GENERAL NOTES. . EXISTING DUCTWORK ON THESE DRAWINGS IS PER EXISTING AS-BUILT DRAWINGS AND ACTUAL CONDITION MIGHT VARY. CONTRACTOR SHALL FIELD VERIFY ALL DEMOLITION AND NEW WORK INSTALLATION PRIOR TO COMMENCEMENT OF
- . THE DRAWINGS INDICATE THE GENERAL ARRANGEMENT OF NEW AND EXISTING PIPING, DUCTWORK AND MECHANICAL EQUIPMENT. THE CONTRACTORS SHALL FOLLOW THIS ARRANGEMENT WHEREVER FEASIBLE. HOWEVER, IT SHALL BE THE RESPONSIBILITY OF THE CONTRACTORS TO VERIFY EXISTING FIELD CONDITIONS AND TO MAKE MINOR MODIFICATIONS TO LOCATIONS, ELEVATIONS ETC., AS REQUIRED. IF A DIFFERENT ARRANGEMENT OTHER THAN THAT SHOWN OR A MINOR OFFSET, RISE OR DROP IS REQUIRED TO CLEAR AN OBSTRUCTION, IT SHALL BE THE CONTRACTOR'S RESPONSIBILITY TO PROVIDE AND INSTALL SUCH WORK AS MAY BE REQUIRED WITHOUT ADDITIONAL COST TO THE OWNER.
- PROVIDE ALL NEW SHEET METAL DUCTWORK, DAMPERS, DIFFUSERS, GRILLES, DUCTWORK INSULATION AND DUCTWORK APPURTENANCES AS INDICATED. INSTALL ALL EQUIPMENT AND COMPONENTS IN ACCORDANCE WITH MANUFACTURER'S PUBLISHED INSTALLATION INSTRUCTIONS WITH RECOMMENDED LOCATIONS TO ENSURE THAT THE SPECIFIED PRODUCTS SERVE THE INTENDED FUNCTION. MAINTAIN PROPER CLEARANCES FOR SERVICE, INSPECTION AND MAINTENANCE OF EQUIPMENT. TERMINATE DEMOLITION AT EXISTING CONSTRUCTION TO REMAIN IN A MANNER THAT SHALL LEAVE STRAIGHT AND
- CLEAN BREAK LINES. USE PRECAUTIONS AND METHODS NOT TO DAMAGE OR DEFACE EXISTING CONSTRUCTION. . ALL CONTRACTORS SHALL COORDINATE AND SCHEDULE THEIR WORK WITH OWNER AND ALL OTHER TRADES TO MINIMIZE THE INTERFERENCE WITH THE OPERATION OF THE BUILDING. ALL CONTRACTORS SHALL TAKE THE NECESSARY PRECAUTIONS TO PROTECT THE OWNER BUILDING AND EQUIPMENT AT ALL TIMES DURING CONSTRUCTION.
- 10. UNDER NO CIRCUMSTANCES SHALL ANY OF THE EXISTING FAN, COOLING OR HEATING SYSTEMS BE SHUT DOWN WITHOUT PRIOR COORDINATION AND APPROVAL OF THE OWNER. 11. THE INSTALLATION OF OF ANTI-STATIC DUST BARRIERS IN THE CONSTRUCTION AREA IS TO BE COORDINATED WITH THE OWNERS REPRESENTATIVE. IF NECESSARY. 12. WHEN INSTALLING PIPING, OR MECHANICAL EQUIPMENT UNDER THIS CONTRACT, THE CONTRACTOR SHALL CONFER WITH
- OTHER CONTRACTORS TO AVOID ANY CONFLICTS BETWEEN THE TRADES. THE CONTRACTOR SHALL BE RESPONSIBLE. AT HIS OWN EXPENSE, FOR THE REMOVAL AND RE-INSTALLATION OF ANY PART OF HIS WORK IF SAME WAS INSTALLED WITHOUT CONSULTING THE OTHER TRADES. 3. SEAL ALL EDGES OF INSULATION ON DUCTWORK, PIPING OR DUCTWORK OR PLENUMS. REPAIR AND PATCH ALL
- INSULATION TO MATCH EXISTING AT AREAS WHERE NEW CONNECTIONS HAVE BEEN MADE TO EXISTING PIPING, DUCTWORK OR EQUIPMENT.
- 14. SEE ELECTRICAL DRAWINGS FOR ADDITIONAL WORK TO BE COORDINATED WITH THESE DRAWINGS. 15. UNDER NO CONDITION, SHOULD ELECTRICAL CONDUITS, FEEDERS AND/OR ANY ON-LINE SERVICE BE DISTURBED, MOVED OR INTERRUPTED UNLESS SPECIFICALLY REQUIRED TO INSTALL NEW DUCTWORK/EQUIPMENT. IT SHALL BE THE RESPONSIBILITY OF THE MECHANICAL CONTRACTOR TO COORDINATE THE RELOCATION OF EXISTING CONDUITS WHERE REQUIRED, WITH THE ELECTRICAL CONTRACTOR, TEMPERATURE CONTROLS CONTRACTOR AND THE OWNER'S REPRESENTATIVE. IF RELOCATION IS REQUIRED, IT SHALL BE DONE AT NO ADDITIONAL COST TO THE OWNER. 6. PROVIDE MANUAL VOLUME DAMPERS AT ALL BRANCH TAKE-OFFS TO DIFFUSERS AND RETURN AIR/EXHAUST GRILLES.
- 17. THE CONTRACTOR SHALL CLEAN-UP ALL DEBRIS CAUSED BY HIS WORK AS IT ACCUMULATES, CONTRACTOR SHALL CLEAN AND DAMP MOP ALL WORK AREAS AND WORK TRAFFIC AREAS AT THE END OF EACH DAY. CONTRACTORS ARE TO CONFINE CONSTRUCTION TRAFFIC TO THE CONSTRUCTION AREA AS MUCH AS POSSIBLE TO MINIMIZE DUST.

CONTROLS CONTRACTOR SCOPE OF WORK

CONTROLS CONTRACTOR TO PROVIDE AIL COMPONENTS, WIRING, AND PROGRAMMING REQUIRED FOR INTEGRATION OF NEW CONTROL PANELS AND DEVICES PROVIDED WITH SPECIFIED MECHANICAL EQUIPMENT INTO EXISTING BMS. REFER TO OWNER'S CONTROL SPECIFICATIONS FOR ADDIIONAL REQUIREMENTS.

	BUILDINGS • EARTH & ENVIRONMENT • EN IDUSTRIAL • INFRASTRUCTURE • SUSTAIN	
THIS RE NO RES STRICTL RESPON	N: DO NOT SCALE DRAWINGS. PRODUCTION MAY BE AT A SIZE DIFFERENT THAN ORIGINALLY DRAWN. PONSIBILITY FOR INCORRECT SCALING. UNAUTHORIZED REPRODUCTIOI Y PROHIBITED. NOT PUBLISHED - ALL RIGHTS RESERVED. EXP EXPRESS ISIBILITY ARISING FROM UNAUTHORIZED USE OF THESE DRAWINGS AND RIZATION MUST BE IN WRITING. 012	N OR REUSE IS SLY DISCLAIMS
1 No.	ADDENDUM #1 Revision	06-29-2018 Date
	ISSUED FOR BID	
Drofoo		
Profes	sional Seal(s)	
Drawn	By: AJJ	
Check		
	Ved By: MLB Printed: 06.18.2018	
File Na		
Projec	Robert W. Depke	
	Juvenile Justice Comp RTU Replacement	
	24647 N Milwaukee Ave, Vernon Hills, IL 60061	
Dwg. ⁻		
	MECHANICAL SHEE SPECIFICATIONS AN	
	GENERAL NOTES	
Projec	CHI-00240054-A1	
Dwg. I	No. Rev.	No.
		•

exp U.S. Services Inc.

Chicago, IL 60601

www.exp.com

+1.312.616.0000 f: +1.312.616.6069 05 North Michigan Avenue, Suite 3600

	GENERAL AB	BREV	IATIONS		PIPING SYSTEM	ABBR	EVIATIONS
°F	DEGREES FAHRENHEIT	MBH	THOUSAND BRITISH THERMAL UNITS PER	AV	AUTOMATIC AIR VENT	MBFV	MOTORIZED BUTTERFLY VALVE
°C	DEGREES CELSIUS		HOUR	BBD	BOILER BLOW DOWN	NPSH	NET POSITIVE SUCTION HEAD
Ø	DIAMETER	MCA	MINIMUM CIRCUIT AMPS	BF	BOILER FEEDWATER	NPSHA	NET POSITIVE SUCTION HEAD AVAILABLE
AD	ACCESS DOOR	MCC	MOTOR CONTROL CENTER	BFV	BUTTERFLY VALVE	NPSHR	NET POSITIVE SUCTION HEAD REQUIRED
ADJ AFF	ADJUSTABLE ABOVE FINISHED FLOOR	ME MECH	MOISTURE ELIMINATOR MECHANICAL	BV CBST	BALL VALVE	OS&Y PG	OUTSIDE STEM AND YOKE PRESSURE GAUGE
AFF	ABOVE FINISHED GRADE	MECH	MEZZANINE	CBSI	COMBO. BALANCING/ SHUTOFF VALVE W/PRESS. TAPS	PG	PRESSURE GAUGE
ARCH	ARCHITECT	MFR	MANUFACTURER	CHV	CHECK VALVE	RED	REDUCER
ATC	AUTOMATIC TEMPERATURE CONTROL	MIN	MINIMUM	со	CLEAN OUT	SOV	SHUT-OFF VALVE
ATV	ATMOSPHERIC VENT	MOCP	MAXIMUM OVERCURRENT PROTECTION	CV	FLOW COEFFICIENT OR CONTROL VALVE	SRV	SAFETY RELIEF VALVE
BFF	BELOW FINISHED FLOOR	MTD	MOUNTED	DOV	DRAIN OFF VALVE	ST	STEAM TRAP
BHP	BRAKE HORSEPOWER BOTTOM OF DUCT	N/A		DX EWT	DIRECT EXPANSION ENTERING WATER TEMPERATURE	STR SV	STRAINER SOLENOID VALVE
BOD BMS	BUILDING MANAGEMENT CONTROL SYSTEM	NC NIC	NORMALLY CLOSED OR NOISE CRITERIA NOT IN CONTRACT	FC	FLEXIBLE CONNECTION	SV S(XXX)	SOLENOID VALVE SECONDARY (SYSTEM DEPENDENT PREFIX)
BOP	BOTTOM OF PIPE	NO	NORMALLY OPEN OR NUMBER	FCV	FLOW CONTROL VALVE	TAV	THERMOSTATIC AIR VENT (STEAM ONLY)
BTU	BRITISH THERMAL UNIT	NOM	NOMINAL	FM	FLOW METER	TDH	TOTAL DYNAMIC HEAD
BTUH	BRITISH THERMAL UNIT PER HOUR	NTS	NOT TO SCALE	GLV	GLOBE VALVE	TH	THERMOMETER
CLG	CEILING	OB	OCTAVE BAND	GV	GATE VALVE	TW	TEST WELL (PETE'S PLUG)
CL	CENTERLINE	OC ODP	ON CENTER OPEN DRIP PROOF	HD	HEAD ISOLATION VALVE	T(XXX) WPD	TERTIARY (SYSTEM DEPENDENT PREFIX)
COL CONC	COLUMN CONCRETE	OFCI	OPEN DRIP PROOF OWNER FURNISHED CONTRACTOR INSTALLED	ISV LWT		VVPD	WATER PRESSURE DROP
CUF	CUBIC FEET	OFOI	OWNER FURNISHED OWNER INSTALLED	MAV	MANUAL AIR VENT		
CYL	CYLINDER	OV	OUTLET VELOCITY				
DB	DRY BULB TEMPERATURE	PCF	POUNDS PER CUBIC FOOT		PIPING I	LEGEN	ND
DDC	DIRECT DIGITAL CONTROL	PD	PRESSURE DROP	011112			
DDCFP	DIRECT DIGITAL CONTROL FIELD PANEL	PH	PHASE	CHWS	- CHILLED WATER SUPPLY		- PIPE ANCHOR
DIM DN	DIMENSION	PLBG POC	PLUMBING POINT OF CONNECTION	CHWR	- CHILLED WATER RETURN		- PIPE GUIDE
DP	DIFFERENTIAL PRESSURE	POD	POINT OF DEMARCATION	CTBD	- COOLING TOWER BLOW DOWN	EJ	- EXPANSION JOINT
DWG	DRAWING	POS	POSITION OR POSITIVE	CTWS	- COOLING TOWER WATER SUPPLY	<u>SLOPE</u>	PIPE SLOPE (REFER TO PLANS FOR
EA	EACH	PSIA	POUNDS PER SQUARE INCH ABSOLUTE				SLOPE)
EFF	EFFICIENCY	PSID	POUNDS PER SQUARE INCH DIFFERENTIAL	CTWR	COOLING TOWER WATER RETURN	<u> </u>	AUTOMATIC AIR VENT
ELEC ELEV	ELECTRICAL	PSIG RC	POUNDS PER SQUARE INCH GAUGE ROOM CRITERIA (NOISE)	CWS	- CONDENSER WATER SUPPLY		ANGLE VALVE - ELEVATION
ELEV EMER	ELEVATION	RET	ROOM CRITERIA (NOISE) RETURN	CWR	- CONDENSER WATER RETURN		- ANGLE VALVE - PLAN
ENT	ENTERING	REQD	REQUIRED	GWS			
EQUIP	EQUIPMENT	RH	RELATIVE HUMIDITY				
EXH	EXHAUST	RM	ROOM	GWR	- GEOTHERMAL WATER RETURN		BALL VALVE W/ MEMORY STOP
EXP	EXPANSION	RPM	REVOLUTIONS PER MINUTE	GS	- GLYCOL SUPPLY	│	- BUTTERFLY VALVE
(E) EXTRM	EXISTING EXISTING TO BE REMOVED	SC SCH	SENSIBLE COOLING SCHEDULE	GR	- GLYCOL RETURN		- BUTTERFLY VALVE W/ MEMORY STOP
ETR	EXISTING TO BE REMOVED	SH	SENSIBLE HEAT			M	
FA	FIRE ALARM	SHT	SHEET	HWS	- HEATING HOT WATER SUPPLY		
FD	FLOOR DRAIN	SPEC	SPECIFICATION	HWR	- HEATING HOT WATER RETURN		PRESSURE INDEPENDENT CONTROL VALVE
FFOP	FIREFIGHTERS OVERRIDE PANEL	SQ	SQUARE	HPWS	- HEAT PUMP WATER SUPPLY		COMBO. BALANCING/ SHUTOFF VALVE W/PRESS. TAPS
FLR	FLOOR	SQFT	SQUARE FEET	HPWR	HEAT PUMP WATER RETURN		
FP FPM	FIRE PROTECTION FEET PER MINUTE	SS STD	STAINLESS STEEL STANDARD				
FT	FEET	SUP	SUPPLY	HCS	TEMP)		- CONTROL VALVE - 3 WAY
FT/SEC	FEET PER SECOND	TAV	THERMOSTATIC AIR VENT	HCR	_ HOT OR COLD WATER RETURN (DUAL TEMP)		- CHECK VALVE
FURN	FURNISHED	TEFC	TOTALLY ENCLOSED FAN COOLED	HTWS-	- HIGH TEMPERATURE WATER SUPPLY		DRAIN OFF VALVE (BALL VALVE W/
FVNR	FULL VOLTAGE NON-REVERSING	TEMP	TEMPERATURE				HOSE BIBB, CAP, & CHAIN)
GA	GAUGE	TOD		HTWR	- HIGH TEMPERATURE WATER RETURN		
gal Galv	GALLONS GALVANIZED	TON TOP	TONS OF REFRIGERATION TOP OF PIPE	MTWS	- MEDIUM TEMPERATURE WATER SUPPLY		FLOW CONTROL VALVE
GPH	GALLONS PER HOUR	UNO	UNLESS NOTED OTHERWISE	MTWR	- MEDIUM TEMPERATURE WATER RETURN	FM	FLOW METER
GPM	GALLONS PER MINUTE	UTR	UP THROUGH ROOF	MUW	– MAKE UP WATER		- FLOW METER - VENTURI
GYP	GYPSUM BOARD	V	VENT				
HP	HORSEPOWER	VAV	VARIABLE AIR VOLUME	PCHWS-	- PROCESS CHILLED WATER SUPPLY		- FLOW SWITCH
HR	HOUR	VEL		-PCHWR-	PROCESS CHILLED WATER RETURN		— GATE VALVE
HZ ID	HERTZ INSIDE DIAMETER	VFD VTR	VARIABLE FREQUENCY DRIVE VENT THROUGH ROOF	RD	- REFRIGERANT DISCHARGE		- GLOBE VALVE
IN	INCHES	W	WIDTH				
KW	KILOWATT	W/	WITH	RL	- REFRIGERANT LIQUID	│ <u> </u>	- ISOLATION VALVE
KVA	KILOVOLT AMPERE	W/O	WITHOUT	RG	- REFRIGERANT GAS	│₽	MANUAL AIR VENT
LB		WB		LPS	- LOW PRESSURE STEAM		- PRESSURE REDUCING VALVE
LF LVG	LINEAR FEET LEAVING	WF WG	WIDE FLANGE WATER GAUGE	LPR	- LOW PRESSURE CONDENSATE RETURN		PRESSURE SUSTAINING VALVE
MAX	MAXIMUM	XFMR	TRANSFORMER				
		<u>I</u>		HPS	- HIGH PRESSURE STEAM		PRESSURE GAUGE
		ייםיט ו		HPR	- HIGH PRESSURE CONDENSATE RETURN		PRESSURE GAUGE W/ COIL SIPHON
	AIR SIDE SYSTEM		KEVIA HUNS	—— G ——	- NATURAL GAS		PUMP (TRIANGLE INDICATES FLOW DIRECTION)
AC	AIR CONDITIONING	LAT	COIL LEAVING AIR TEMPERATURE		DOUBLE LINE PIPE RISE		
ACD		MA				•	
AF APD	AIR FOIL AIR PRESSURE DROP	MAT MAU	MIXED AIR TEMPERATURE MAKE UP AIR		SINGLE LINE PIPE RISE		QUICK OPENING VALVE
apd At	AIR PRESSURE DROP AIR TERMINAL	MAU OA	OUTSIDE AIR	200	DOUBLE LINE PIPE DROP	_ F卒_	SAFETY RELIEF VALVE
AVS	AIR VOLUME TRAVERSE STATION	OAI	OUTSIDE AIR INTAKE		SINGLE LINE PIPE DROP	S X	SOLENOID VALVE
BI	BACKWARD INCLINE	OBD	OPPOSED BLADE DAMPER				_
BDD	BACKDRAFT DAMPER	OED	OPEN END DUCT	O	- PIPE TEE OFF THE TOP	8	- STRAINER - DUPLEX
CD	CEILING DIFFUSER (SUPPLY)	P.E.	PNEUMATIC - ELECTRIC		PIPE TEE OFF THE BOTTOM		
CFM CV	CUBIC FEET PER MINUTE CONSTANT VOLUME	R / RA RAT	RETURN AIR RETURN AIR TEMPERATURE		PIPE TEE OFF THE SIDE		STRAINER W/ DRAIN VALVE, HOSE BIBB, & CAP (USE GATE VALVE FOR
CV DL/ UC	CONSTANT VOLUME DOOR LOUVER / UNDERCUT DOOR	RAT	RETURN AIR TEMPERATURE RETURN AIR GRILLE OR REGISTER		BLIND FLANGE		STEAM) — STRAINER - BASKET TYPE W/ DRAIN
DWDI	DOUBLE WIDTH DOUBLE INLET	RLF	RELIEF				
DWSI	DOUBLE WIDTH SINGLE INLET	RV	ROOF VENT		END CAP	$ - \otimes -$	- STEAM TRAP
EA	EXHAUST AIR	S / SA	SUPPLY AIR		ਟ PIPE BREAK		THERMOSTATIC AIR VENT (STEAM ONLY)
EAT	COIL ENTERING AIR OR EXHAUST AIR TEMP.	SAT				μ	THERMOMETER
EG EP	EXHAUST AIR GRILLE OR REGISTER ELECTRIC - PNEUMATIC	SI SP	DUCT WITH LINING OR SOUND INSULATION STATIC PRESSURE			=	—
ESP	EXTERNAL STATIC PRESSURE	SP	STAILC PRESSURE STAINLESS STEEL DUCT		CLEAN OUT		TEST WELL (PETE'S PLUG)
F&B	FACE AND BYPASS	SWDI	SINGLE WIDTH DOUBLE INLET		- DIRECTION OF FLOW		TRIPLE DUTY VALVE
FC	FOWARD CURVE OR FLEXIBLE CONNECTION	SWSI	SINGLE WIDTH SINGLE INLET	│⊅	- REDUCER - CONCENTRIC		- UNION
FA		TG			- REDUCER - ECCENTRIC	V	VACUUM BREAKER
FPI GE	FINS PER INCH GENERAL EXHAUST	TSP VAV	TOTAL STATIC PRESSURE VARIABLE AIR VOLUME				-
HEGA	HIGH EFFICIENCY GAS ABSORBER AIR FILTER	WMS	WIRE MESH SCREEN		- FLEXIBLE CONNECTION		

AC	AIR CONDITIONING	LAT	COIL LEAVING AIR TEMPERATURE		
ACD	AUTOMATIC CONTROL DAMPER	MA	MIXED AIR	4	DOUBLE L
AF	AIR FOIL	MAT	MIXED AIR TEMPERATURE	· · · · · · · · · · · · · · · · · · ·	SINGLE LII
APD	AIR PRESSURE DROP	MAU	MAKE UP AIR		
AT	AIR TERMINAL	OA	OUTSIDE AIR		DOUBLE L
AVS	AIR VOLUME TRAVERSE STATION	OAI	OUTSIDE AIR INTAKE	сЭ	SINGLE LII
BI	BACKWARD INCLINE	OBD	OPPOSED BLADE DAMPER		
BDD	BACKDRAFT DAMPER	OED	OPEN END DUCT		PIPE TEE
CD	CEILING DIFFUSER (SUPPLY)	P.E.	PNEUMATIC - ELECTRIC		PIPE TEE
CFM	CUBIC FEET PER MINUTE	R / RA	RETURN AIR	<u> </u>	
CV	CONSTANT VOLUME	RAT	RETURN AIR TEMPERATURE		PIPE TEE
DL/ UC	DOOR LOUVER / UNDERCUT DOOR	RG	RETURN AIR GRILLE OR REGISTER		BLIND FLA
DWDI	DOUBLE WIDTH DOUBLE INLET	RLF	RELIEF		
DWSI	DOUBLE WIDTH SINGLE INLET	RV	ROOF VENT		END CAP
EA	EXHAUST AIR	S/SA	SUPPLY AIR	· · · · · · · · · · · · · · · · · · ·	PIPE BREA
EAT	COIL ENTERING AIR OR EXHAUST AIR TEMP.	SAT	SUPPLY AIR TEMPERATURE		
EG	EXHAUST AIR GRILLE OR REGISTER	SI	DUCT WITH LINING OR SOUND INSULATION		DIRT LEG
EP	ELECTRIC - PNEUMATIC	SP	STATIC PRESSURE		CLEAN OU
ESP	EXTERNAL STATIC PRESSURE	SS	STAINLESS STEEL DUCT		DIDEOTIO
F&B	FACE AND BYPASS	SWDI	SINGLE WIDTH DOUBLE INLET		DIRECTIO
FC	FOWARD CURVE OR FLEXIBLE CONNECTION	SWSI	SINGLE WIDTH SINGLE INLET		REDUCER
FA	FREE AREA	TG	TRANSFER AIR GRILLE		
FPI	FINS PER INCH	TSP	TOTAL STATIC PRESSURE		REDUCER
GE	GENERAL EXHAUST	VAV	VARIABLE AIR VOLUME		FLEXIBLE
HEGA	HIGH EFFICIENCY GAS ABSORBER AIR FILTER	WMS	WIRE MESH SCREEN		
HEPA	HIGH EFFICIENCY PARTICULATE AIR FILTER				

	CONTROL DIAGRA	m abe	BREVIATIONS
AI	ANALOG INPUT CONTROL POINT	BO	BINARY OUTPUT CONTROL POINT
AO	ANALOG OUTPUT CONTROL POINT	EMS	ENERGY MANAGEMENT SYSTEM
ASD	ADJUSTABLE SPEED DRIVE	NC	NORMALLY CLOSED WHEN OFF
BAS	BUILDING AUTOMATION CONTROL SYSTEM	NO	NORMALLY OPEN WHEN OFF
BI	BINARY INPUT CONTROL POINT	VFD	VARIABLE FREQUENCY DRIVE

	REDUCER - ECCENTRIC		VACUUM BREAKER
	FLEXIBLE CONNECTION		
	DEMO	LITION	
< C >	CAP EXISTING		DEMOLITION PIPING
< X >	EXISTING TO REMAIN	X	DEMOLITION EQUIPMENT OR DUCT
< R >	EXISTING TO BE REMOVED		
< RL >	EXISTING TO BE RELOCATED		
< NL >	EXISTING - NEW LOCATION		

	CONTROL DIA	GRAM L	EGEND
-/-/-2	MOTORIZED DAMPER - 2 POSITION	~~~_ T	SERPENTINE TEMPERATURE SENSOR
—/-/- M	MOTORIZED DAMPER - MODULATING	О−− Н	DUCT HUMIDITY SENSOR
xSC	MOTORIZED DAMPER - SPRING CLOSED	⊂— E	ENTHALPY SENSOR
xso	MOTORIZED DAMPER - SPRING OPEN	⊂—EC—⊙	COMPARATIVE ENTHALPY SWITCH
xSM	MOTORIZED DAMPER - SMOKE DAMPER SPRING CLOSED UL-555S	HHL	HIGH LIMIT HUMIDITY - SWITCH
SF	MOTORIZED DAMPER - FIRE/ SMOKE DAMPER, 2 POSITION, SPRING CLOSED	TLL	LOW LIMIT THERMOSTAT - SWITCH
		THL	HIGH LIMIT THERMOSTAT - SWITCH
∐ ∦	3-WAY CONTROL VALVE	SP	DIFFERENTIAL STATIC PRESSURE SENSOR
		DP	DIFFERENTIAL PRESSURE SENSOR (ANALO
X	2-WAY CONTROL VALVE	DPS	DIFFERENTIAL PRESSURE SWITCH
	BUTTERFLY CONTROL VALVE	SHL	STATIC PRESSURE - HIGH LIMIT SWITCH
		SLL	STATIC PRESSURE - LOW LIMIT SWITCH
2	2 POSITION	FM	FLOW METER
Μ	MODULATING	СТ	CURRENT TRANSDUCER SENSOR (ANALOG)
2SC	2 POSITION - SPRING CLOSED	CTS	CURRENT TRANSDUCER SWITCH
2SO	2 POSITION - SPRING OPEN	R	RELAY
MSC	MODULATING - SPRING CLOSED	$(M) \stackrel{\perp}{\top}$	RELAY CONTACTOR - OPEN WITH NO CONTROL POWER
MSO	MODULATING - SPRING OPEN	$(M) \neq 1$	RELAY CONTACTOR - CLOSED WITH NO CONTROL POWER
F	FLOATING - 24VAC	R	TRANSFORMER
(T)	ROOM TEMPERATURE SENSOR		FUSE
H	ROOM HUMIDITY SENSOR	-//	TWISTED PAIR MULTI-SIGNAL CONTROL WIRING
	ROOM THERMOSTAT		DUCT MOUNTED SMOKE DETECTOR (S) SUPPLY DUCT MOUNTED
	PIPE TEMPERATURE SENSOR	S S P	(R) RETURN DUCT MOUNTED (I) IONIZATION (P) PHOTOELECTRIC
○— T	DUCT TEMPERATURE SENSOR		

	AIR SYSTE	M LEGE	IND
7	RECTANGULAR SUPPLY/ OUTSIDE AIR DUCT UP	CFM	SPACE PRESSURIZATION ARROW
	RECTANGULAR SUPPLY/ OUTSIDE AIR DUCT DOWN		DOOR LOUVER / UNDERCUT DOOR
7	RECTANGULAR RETURN/ RELIEF AIR DUCT UP		SUPPLY AIRFLOW ARROW
	RECTANGULAR RETURN/ RELIEF AIR DUCT DOWN	-~->	RETURN OR EXHAUST AIRFLOW ARROW
	RECTANGULAR EXHAUST AIR DUCT UP		AIR VOLUME TRAVERSE STATION
	RECTANGULAR EXHAUST AIR DUCT DOWN		CEILING DIFFUSER (SUPPLY)
7	ROUND SUPPLY/ OUTSIDE AIR DUCT UP		RETURN AIR GRILLE OR REGISTER
200	ROUND SUPPLY/ OUTSIDE AIR DUCT DOWN		EXHAUST AIR GRILLE OR REGISTER
7	ROUND RETURN/ RELIEF AIR DUCT UP		DIFFUSER WITH FLOW DIRECTION.
20	ROUND RETURN/ RELIEF AIR DUCT DOWN	↓ ↓ ↓	NO FLOW ARROWS INDICATES STANDARD 4-WAY PATTERN.
7 8	ROUND EXHAUST AIR DUCT UP		SIDE WALL GRILLE
	ROUND EXHAUST AIR DUCT DOWN	(H) <u>X</u>	HUMIDITY SENSOR OR HUMIDISTAT AND NUMBER
	DUCT WITH LINING OR SOUND INSULATION	<u>(s) x</u>	SENSOR AND NUMBER
	STAINLESS STEEL DUCT	S₩ X	SWITCH AND NUMBER
	PVC COATED DUCT	<u>x</u> (T)	TEMPERATURE SENSOR OR THERMOSTAT & ZONE NUMBER
	DOUBLE WALL DUCT	<u>X</u>	TEMPERATURE SENSOR OR THERMOSTAT W/ VANDAL GUARD & ZONE NUMBER
ACD	AUTOMATIC CONTROL DAMPER FOR ROUND AND RECTANGULAR DUCT	YM	REMOTE DAMPER OPERATOR
BDD	BACKDRAFT DAMPER FOR ROUND AND RECTANGULAR DUCT	DP	DIFFERENTIAL PRESSURE SENSOR
FD 7	FIRE DAMPER FOR ROUND AND RECTANGULAR DUCT	SD	DUCT SMOKE DETECTOR
SD 7	SMOKE DAMPER FOR ROUND AND RECTANGULAR DUCT	SP	STATIC PRESSURE SENSOR
SFD	COMBINATION SMOKE/FIRE DAMPER FOR ROUND AND RECTANGULAR DUCT	CO	CARBON MONOXIDE SENSOR
SGD	SLIDE GATE DAMPER FOR ROUND AND RECTANGULAR DUCT	(CO2)	CARBON DIOXIDE SENSOR
VD	MANUAL VOLUME DAMPER FOR ROUND AND RECTANGULAR DUCT		
	FLEXIBLE CONNECTION		

TAGS AND CALL OUT SYMBOLS

EQUIP #	EQUIPMENT REQUIRING ELECTRICAL SERVICE. REFER TO SCHEDULES FOR PERFORMANCE REQUIREMENTS.	/# <[1]
EQUIP #	EQUIPMENT <u>NOT</u> REQUIRING ELECTRICAL SERVICE. REFER TO SCHEDULES FOR PERFORMANCE REQUIREMENTS.	
	SECTION CALLOUT	
1 M3.1	 SECTION DESIGNATION SHEET NUMBER 	
A	DETAIL CALLOUT — DETAIL DESIGNATION — SHEET NUMBER	

YMBOLS
REVISION CALLOUT
KEYNOTE CALLOUT
POINT OF CONNECTION
POINT OF DEMARCATION

© exp, 2	ISBILITY ARISING FROM UNAUTHORIZED USE OF THESE DRAWINGS AND RIZATION MUST BE IN WRITING. 2012	nores.
No.	Revision	Date
	ISSUED FOR BID	
_		
Profes	sional Seal(s)	
Drawn	By: AJJ	
Check		
	Ved By: MLB	
	CHI 00240054 A1 rfa	
File Na Projec		
	Robert W. Depke	
	Juvenile Justice Comp	
	RTU Replacement 24647 N Milwaukee Ave,	
	Vernon Hills, IL 60061	
Dwg. T	Title	
	MECHANICAL LEGEN	
	AND SYMBOLS	
Projec	^{t No.} CHI-00240054-A1	
Dwg. N	No. Rev.	No.
	M002	

exp U.S. Services Inc.

www.exp.com


t: +1.312.616.0000 f: +1.312.616.6069 205 North Michigan Avenue, Suite 3600 Chicago, IL 60601 USA

BUILDINGS • EARTH & ENVIRONMENT • ENERGY •

INDUSTRIAL • INFRASTRUCTURE • SUSTAINABILITY •

CAUTION: DO NOT SCALE DRAWINGS. THIS REPRODUCTION MAY BE AT A SIZE DIFFERENT THAN ORIGINALLY DRAWN. EXP ASSUMES NO RESPONSIBILITY FOR INCORRECT SCALING. UNAUTHORIZED REPRODUCTION OR REUSE IS STRICTLY PROHIBITED. NOT PUBLISHED - ALL RIGHTS RESERVED. EXP EXPRESSLY DISCLAIMS RESPONSIBILITY ARISING FROM UNAUTHORIZED USE OF THESE DRAWINGS AND NOTES. AUTHORIZATION MUST BE IN WRITING.

ЭХр.

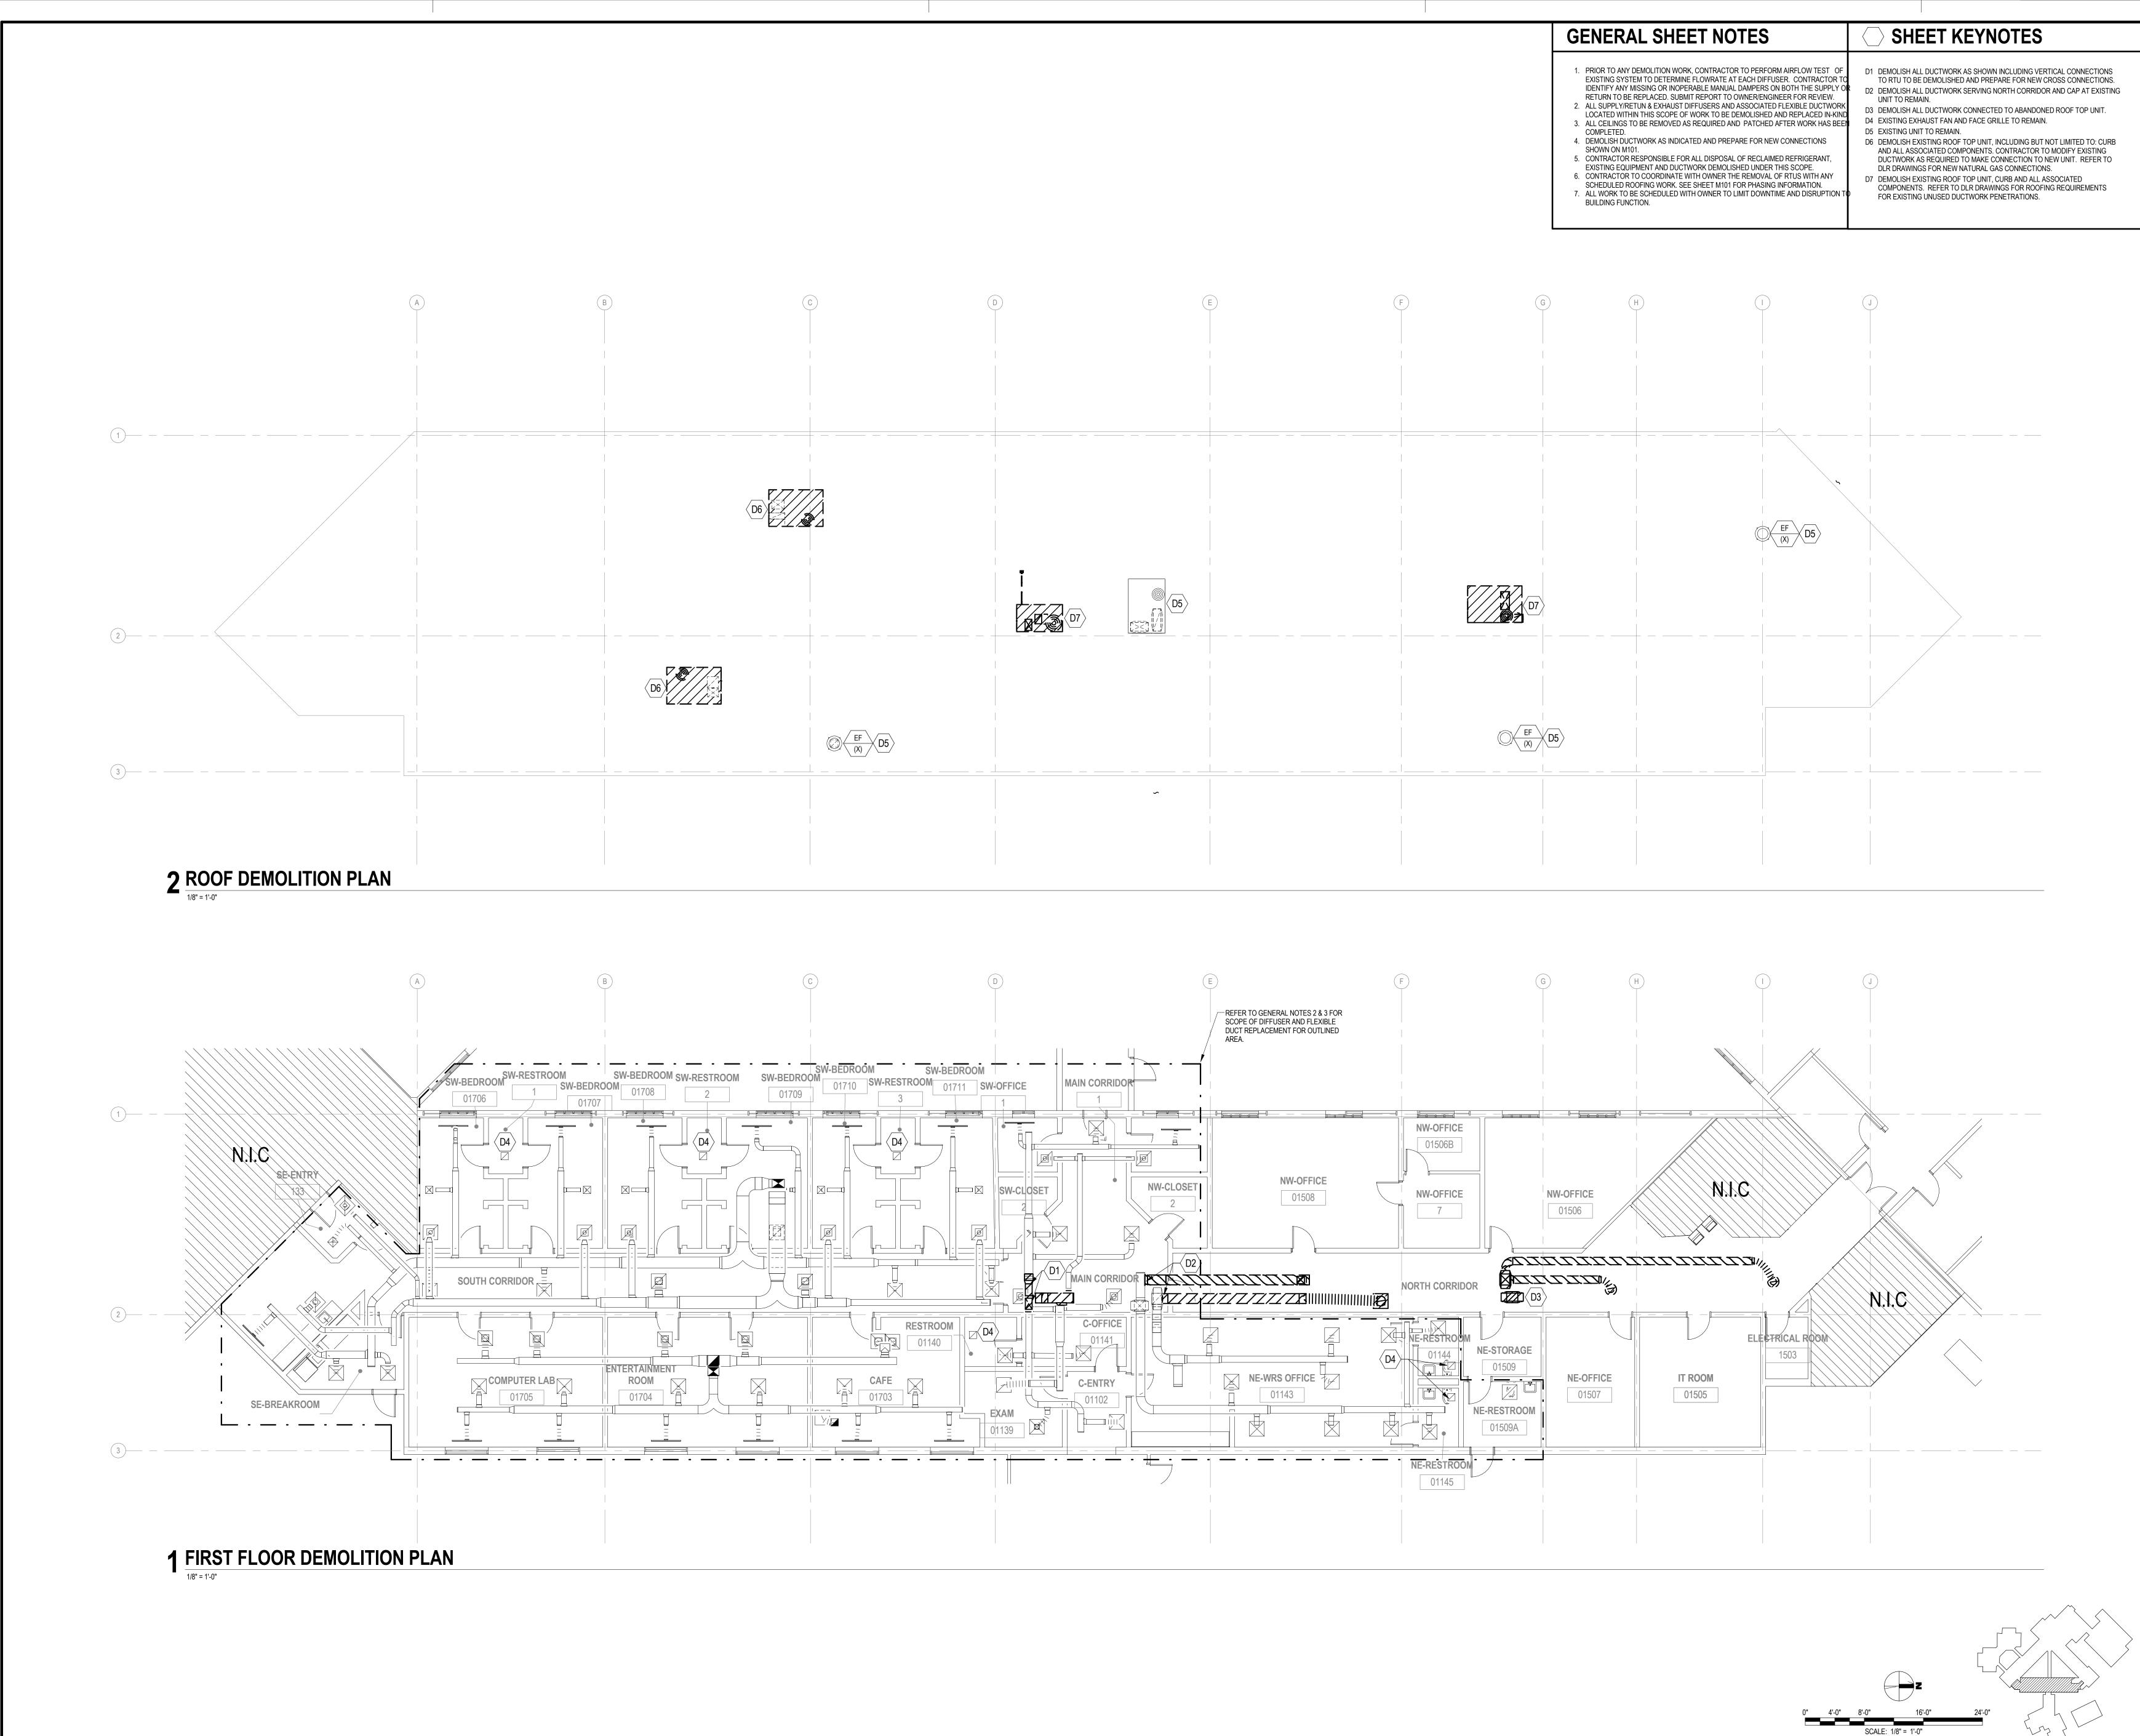


	BUILDINGS • EARTH & ENVIRONMENT • EN DUSTRIAL • INFRASTRUCTURE • SUSTAIN	
THIS REP NO RESP STRICTLY RESPONS	: DO NOT SCALE DRAWINGS. RODUCTION MAY BE AT A SIZE DIFFERENT THAN ORIGINALLY DRAWN. ONSIBILITY FOR INCORRECT SCALING. UNAUTHORIZED REPRODUCTIO PROHIBITED. NOT PUBLISHED - ALL RIGHTS RESERVED. EXP EXPRESS SIBILITY ARISING FROM UNAUTHORIZED USE OF THESE DRAWINGS AND ZATION MUST BE IN WRITING.	N OR REUSE IS SLY DISCLAIMS
© exp, 20	12	
No.	Revision	Date
	ISSUED FOR BID	
Profess	sional Seal(s)	
	T	
Drawn	By: AJJ	
Checke		
Approv Date Pi		
File Na		
Project	Robert W. Depke	
	Juvenile Justice Comp RTU Replacement	
	24647 N Milwaukee Ave, Vernon Hills, IL 60061	
Dwg. T		
<i>∽</i> wy. I	FIRST FLOOR	
	MECHANICAL DEMOLITION PLAN	
Project		
Dwg. N	CHI-00240054-A1	No.
	MD101	

exp U.S. Services Inc.

www.exp.com

t: +1.312.616.0000 f: +1.312.616.6069 205 North Michigan Avenue, Suite 3600 Chicago, IL 60601 USA

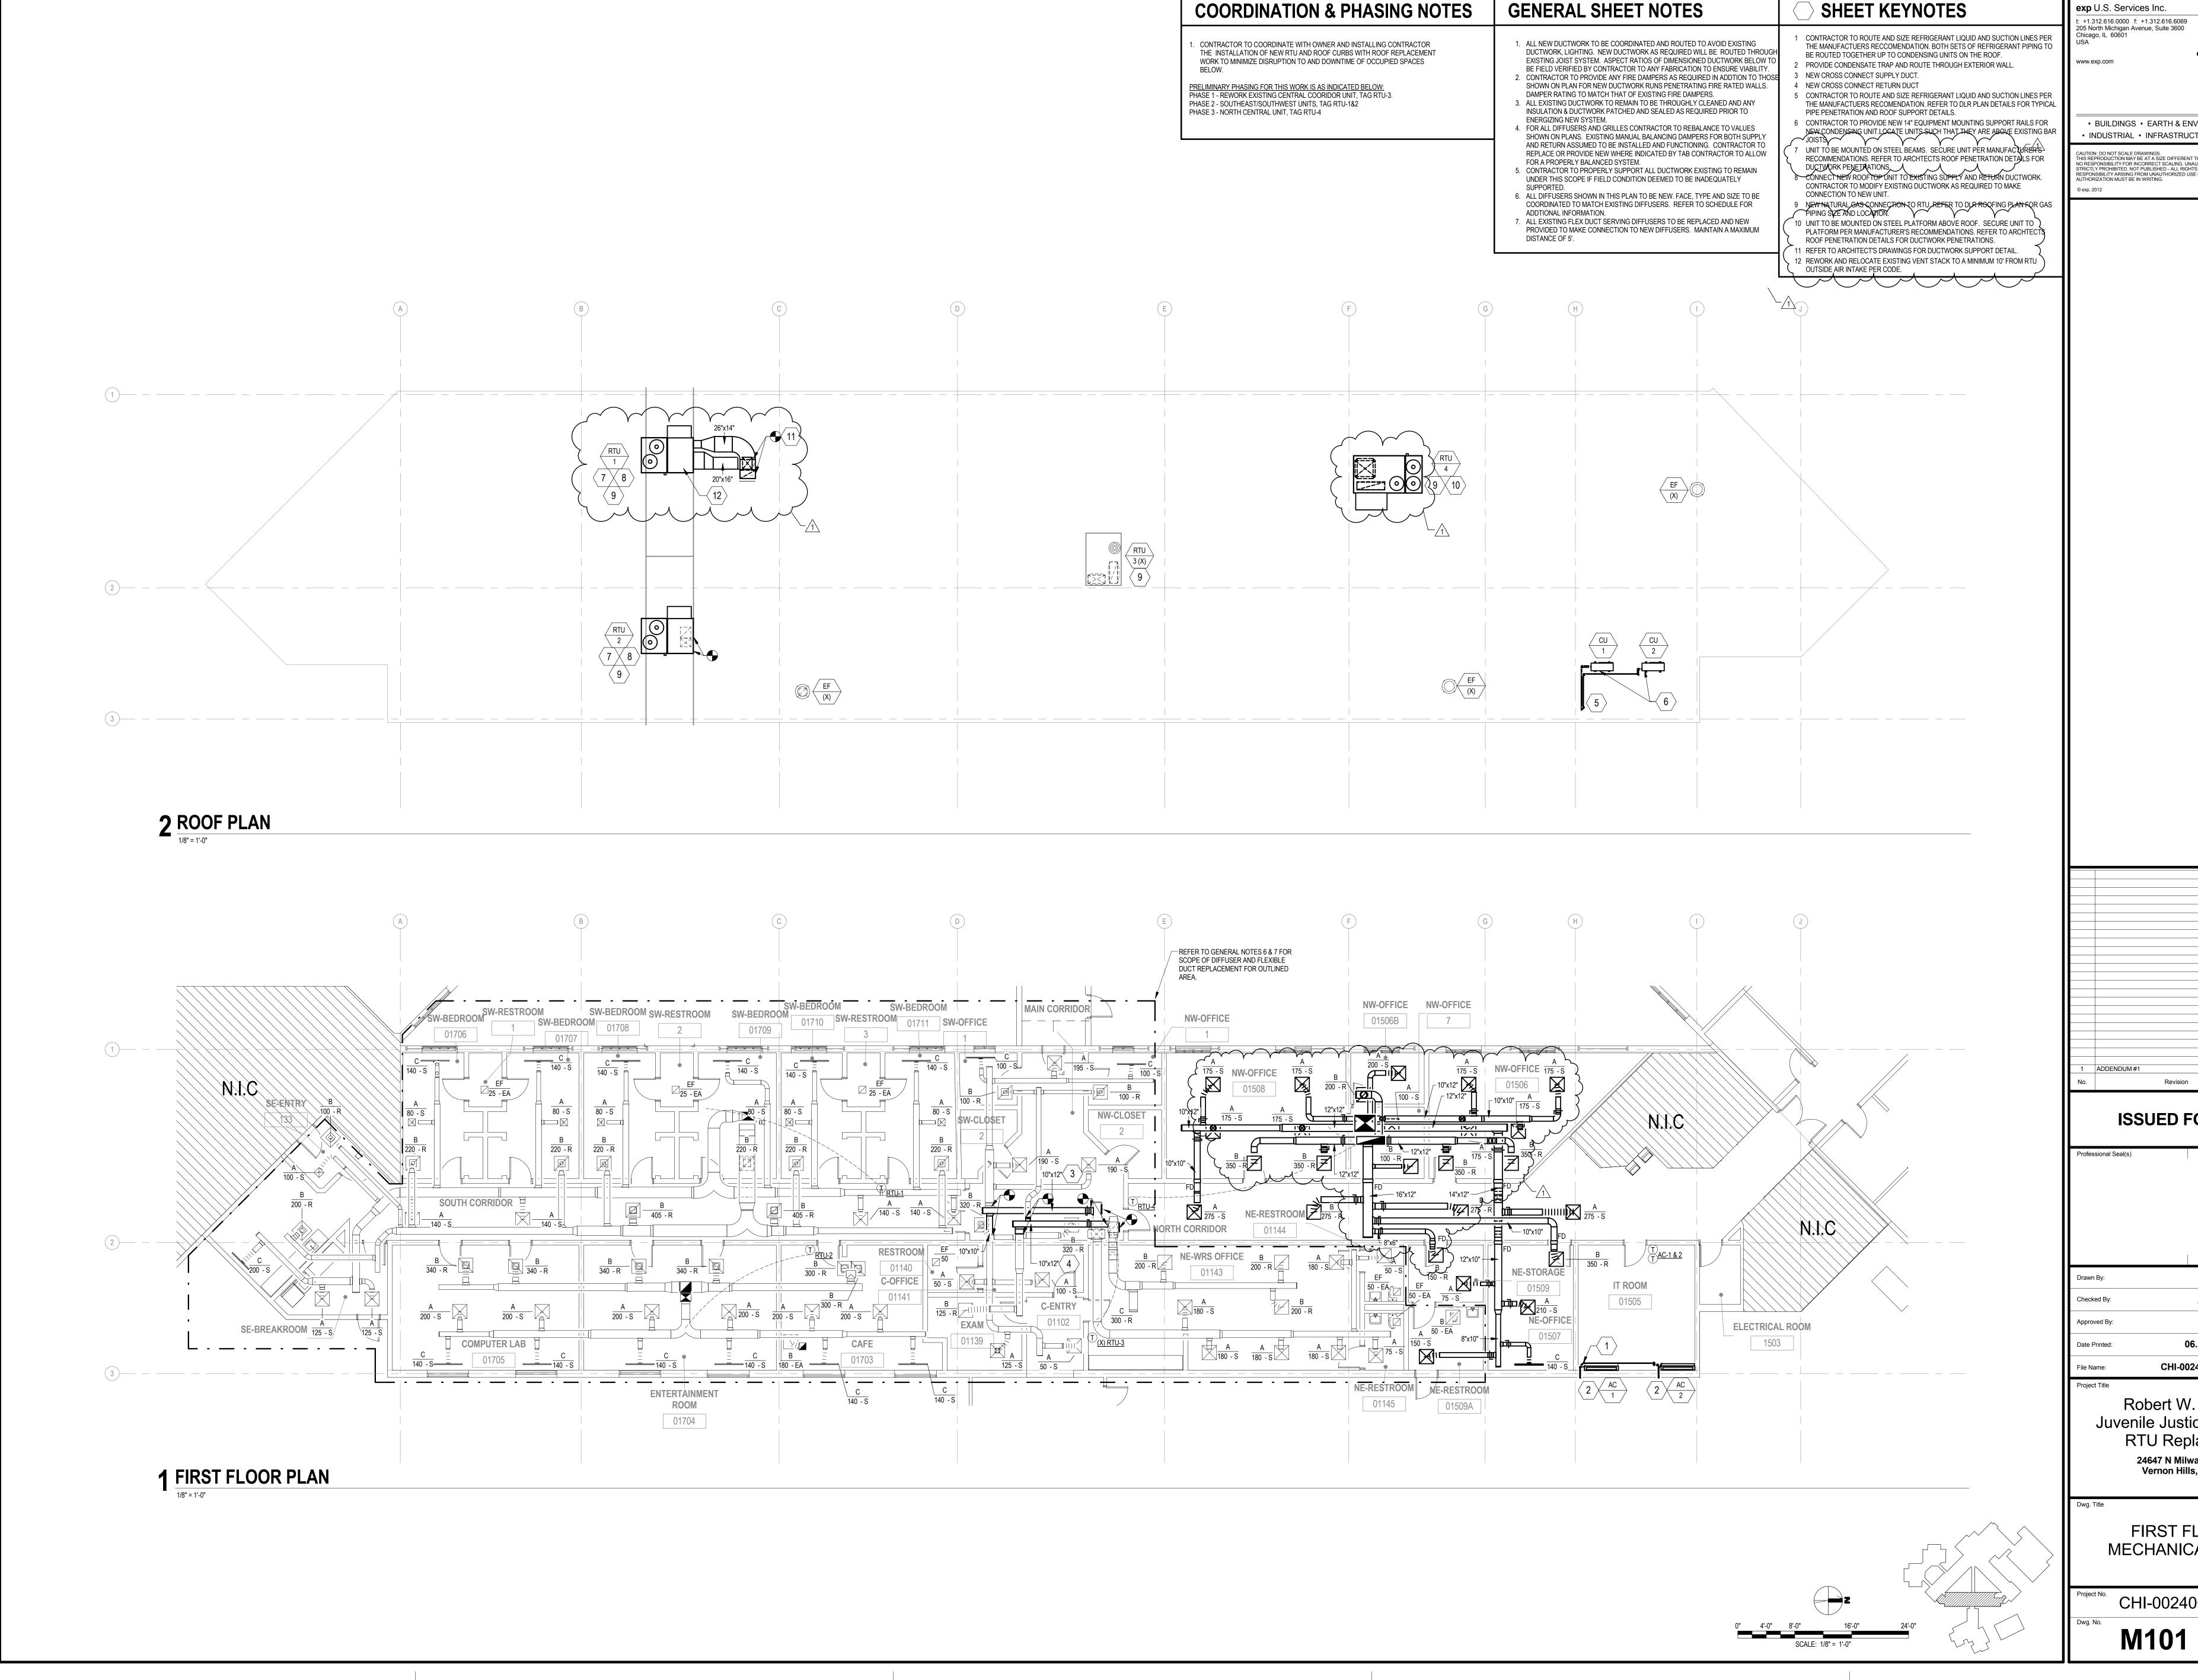


INDUSTRIAL • INFRASTRUCTURE • SUSTAIN CAUTION: DO NOT SCALE DRAWINGS. THIS REPRODUCTION MAY BE AT A SIZE DIFFERENT THAN ORIGINALLY DRAWN. NO RESPONSIBILITY FOR INCORRECT SCALING. UNAUTHORIZED REPRODUCTION STRICTLY PROHIBITED. NOT PUBLISHED - ALL RIGHTS RESERVED. EXP EXPRESS RESPONSIBILITY ARISING FROM UNAUTHORIZED USE OF THESE DRAWINGS AND AUTHORIZATION MUST BE IN WRITING. © exp. 2012	EXP ASSUMES N OR REUSE IS SLY DISCLAIMS
© exp, 2012	
1 ADDENDUM #1 No. Revision	06-29-2018 Date
ISSUED FOR BID	
Professional Seal(s)	
Drawn By: AJJ	
Checked By: AJW Approved By: MLB	
Date Printed: 06.18.2018	
File Name: CHI-00240054-A1.rfa Project Title Image: CHI-00240054-A1.rfa	
Robert W. Depke Juvenile Justice Comp	
RTU Replacement 24647 N Milwaukee Ave, Vernon Hills, IL 60061	
MECHANICAL PLAN	l
Project No. CHI-00240054-A1 Dwg. No. Rev.	No.
M101	1


exp U.S. Services Inc.

• BUILDINGS • EARTH & ENVIRONMENT • ENERGY •


www.exp.com

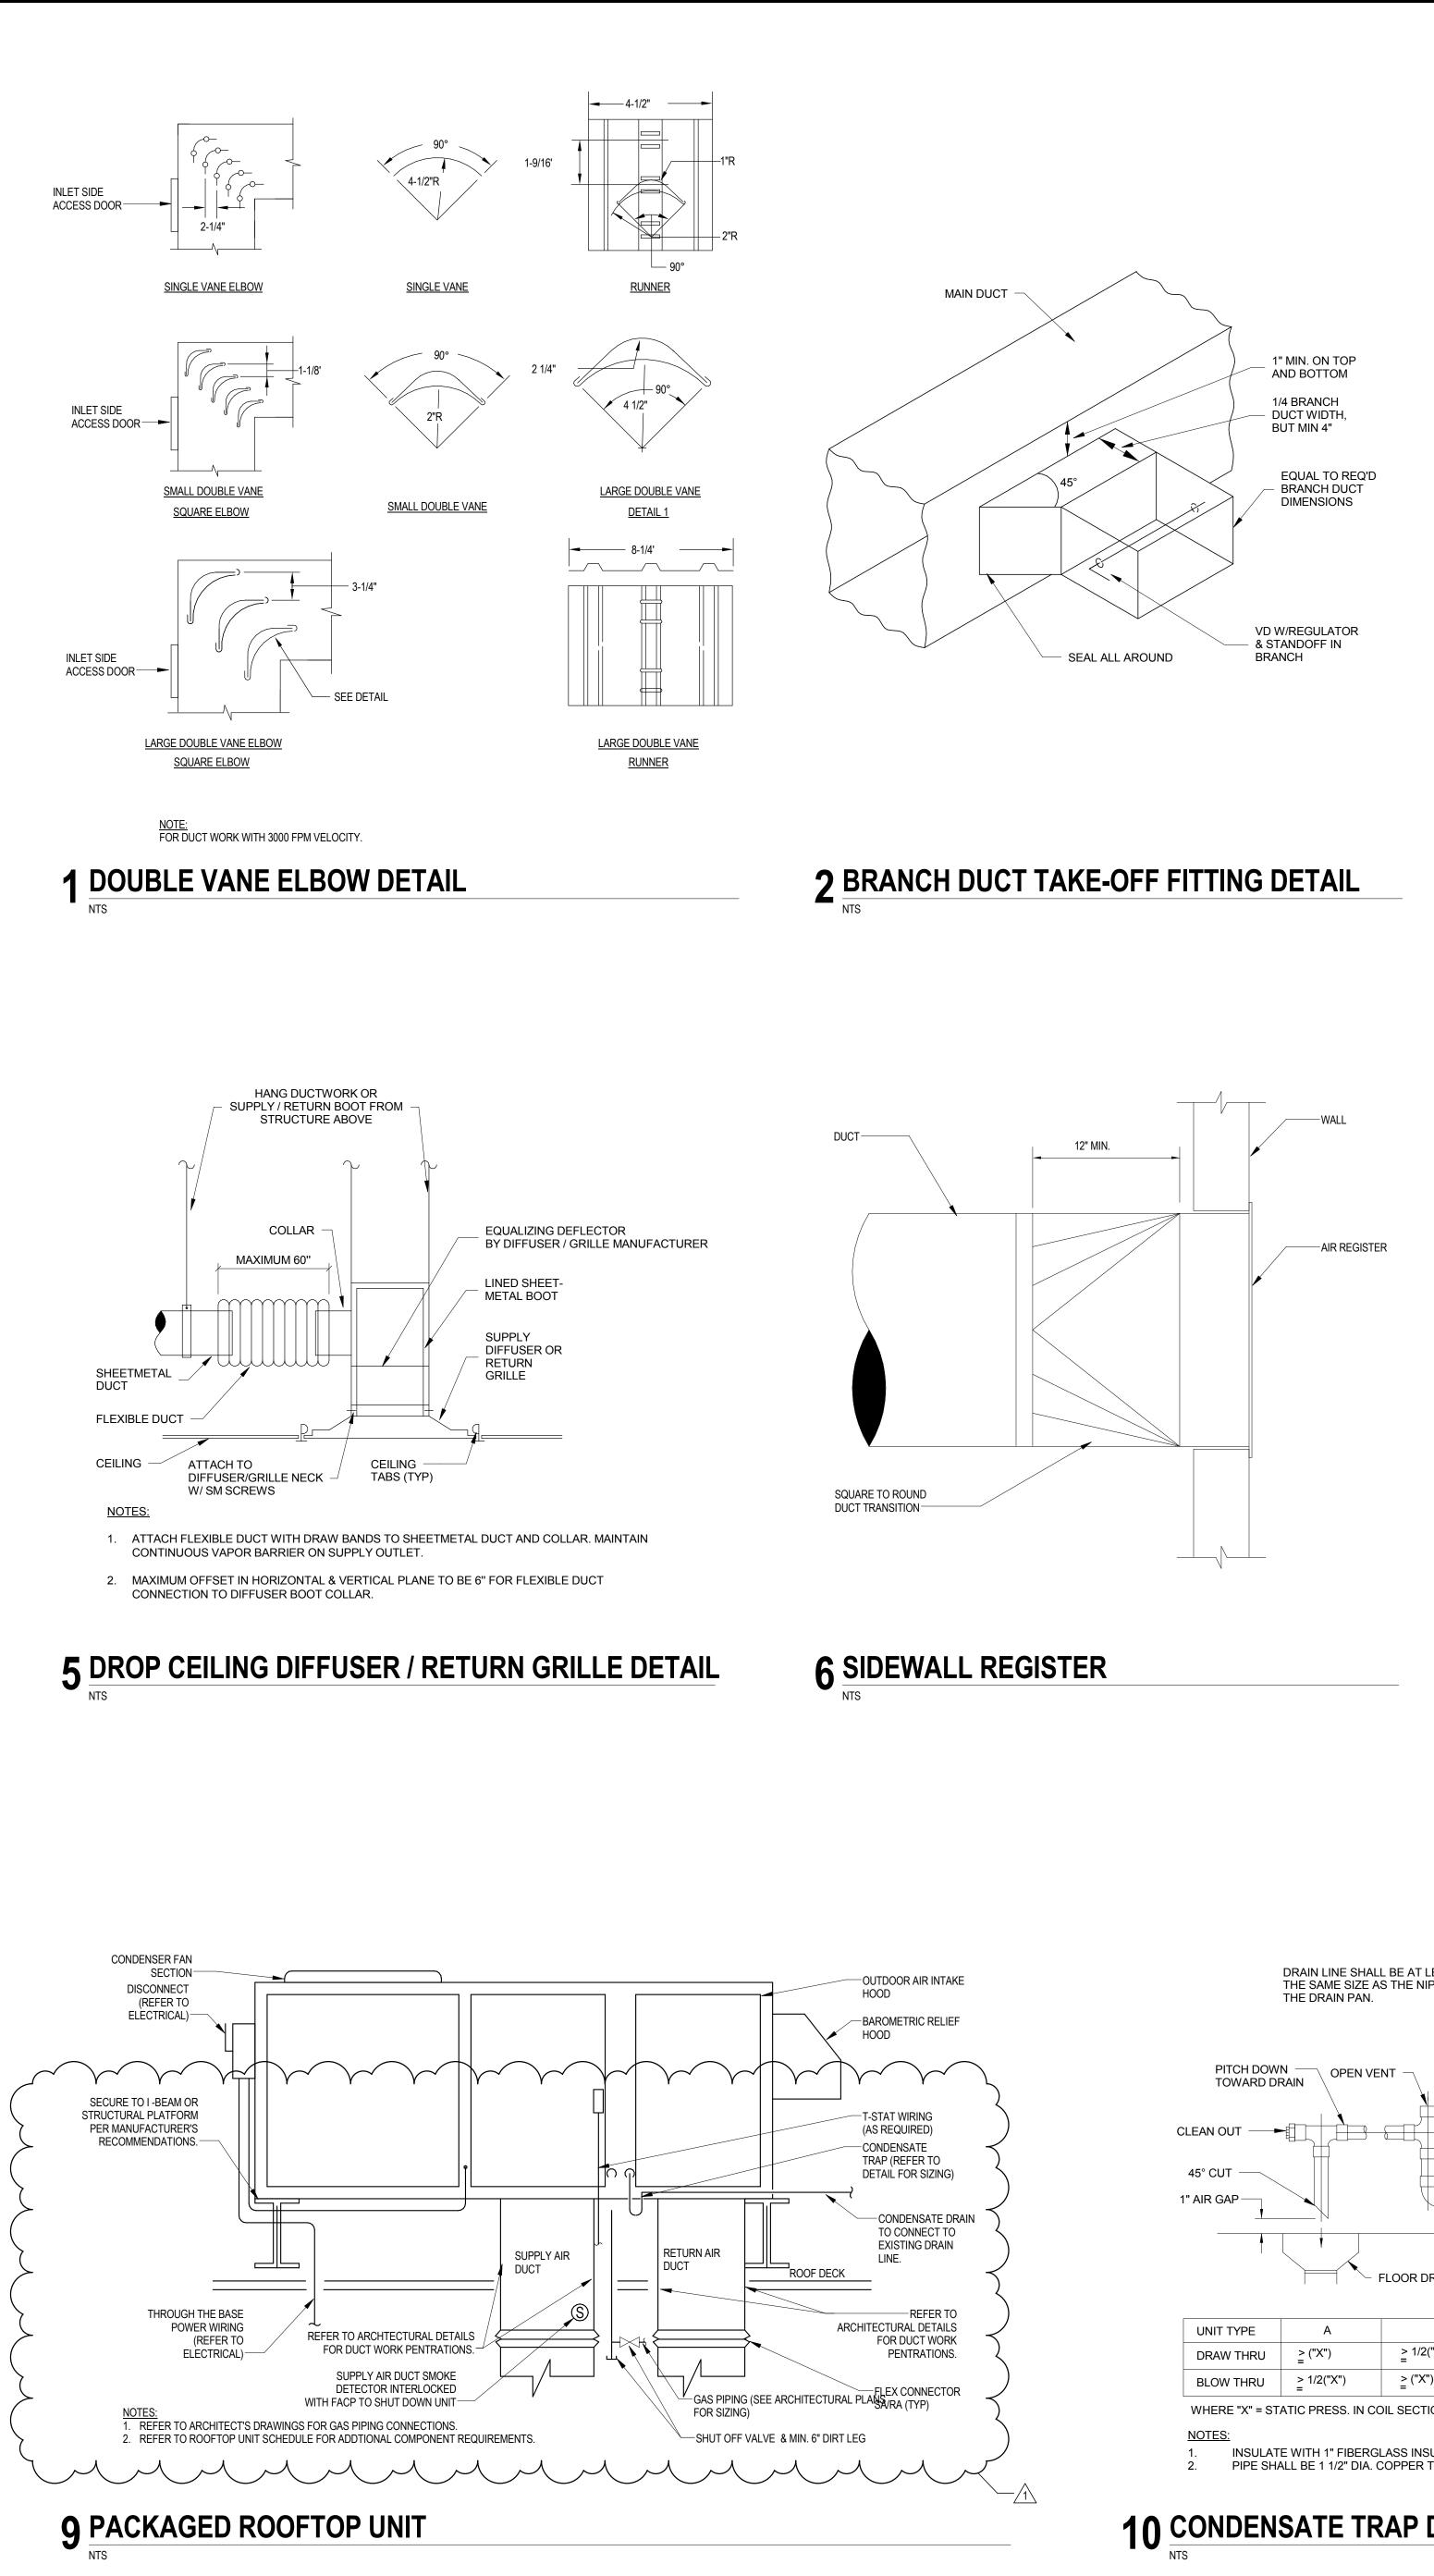


10 CONDENSATE TRAP DETAIL

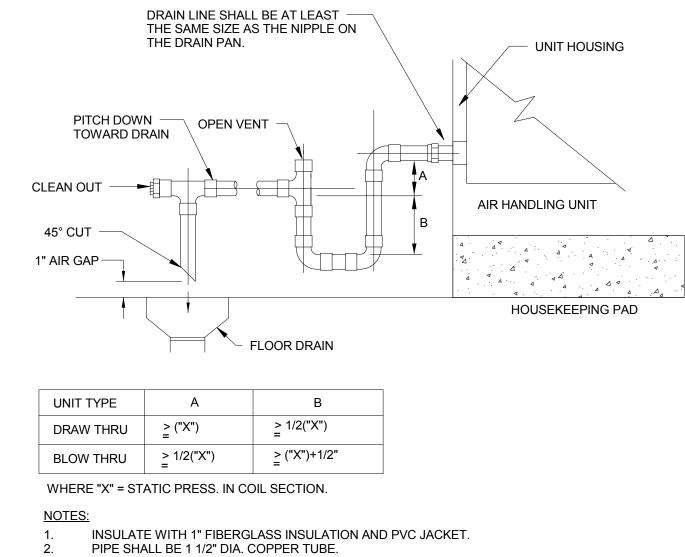





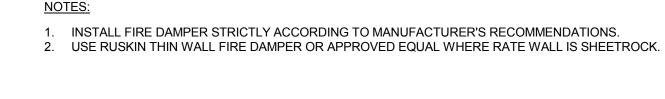

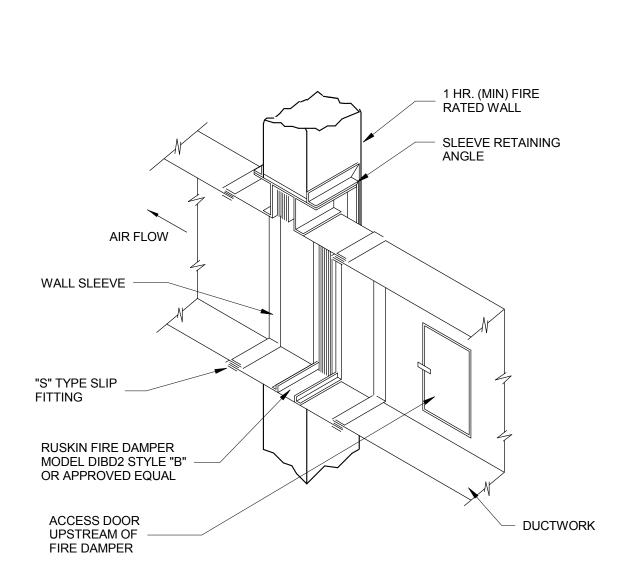


3 DUCT HANGER SUPPORT

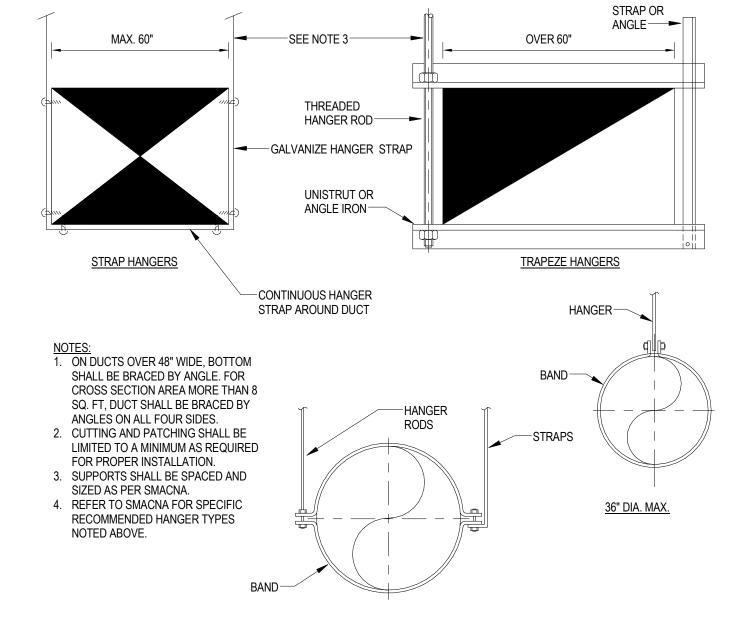

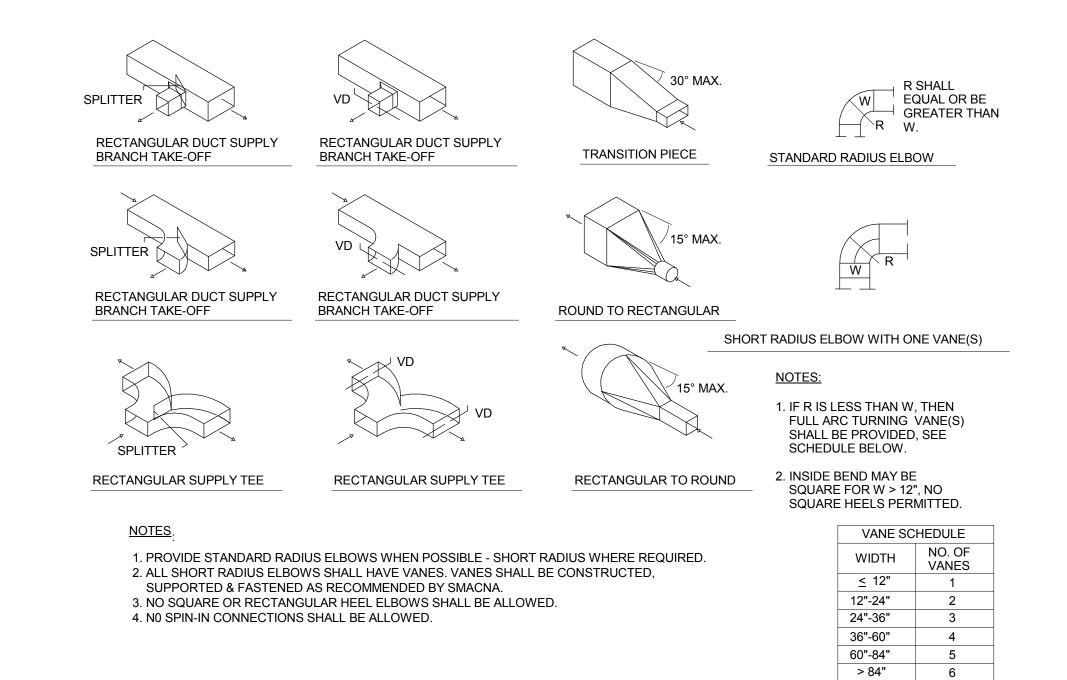



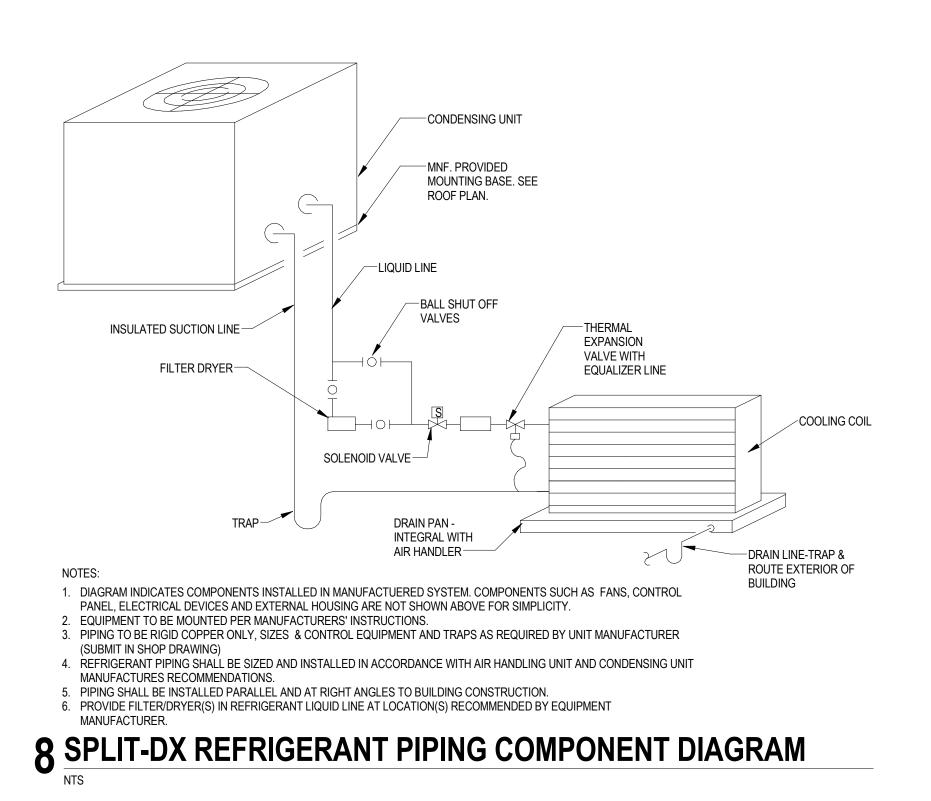

INDUSTRIAL • INFRASTRUCTURE • SUSTAIN CAUTION: DO NOT SCALE DRAWINGS. THIS REPRODUCTION MAY BE AT A SIZE DIFFERENT THAN ORIGINALLY DRAWN. NO RESPONSIBILITY FOR INCORRECT SCALING. UNAUTHORIZED REPRODUCTIO STRICTLY PROHIBITED. NOT PUBLISHED - ALL RIGHTS RESERVED. EXP EXPRESS RESPONSIBILITY ARISING FROM UNAUTHORIZED USE OF THESE DRAWINGS AND	EXP ASSUMES N OR REUSE IS SLY DISCLAIMS
AUTHORIZATION MUST BE IN WRITING.	
1 ADDENDUM #1 No. Revision	06-29-2018 Date
ISSUED FOR BID	
Professional Seal(s)	
Drawn By: AJJ	
Checked By: AJW Approved By: MLB	
Date Printed: 06.18.2018	
File Name: CHI-00240054-A1.rfa Project Title Project Title	
Robert W. Depke Juvenile Justice Comp	
RTU Replacement 24647 N Milwaukee Ave,	
Vernon Hills, IL 60061	
Dwg. Title	_
MECHANICAL DETAI	_S
Project No. CHI-00240054-A1	
Dwg. No. Rev.	No.
	-

exp U.S. Services Inc.

Chicago, IL 60601

www.exp.com


USA

5

6

t: +1.312.616.0000 f: +1.312.616.6069 205 North Michigan Avenue, Suite 3600

• BUILDINGS • EARTH & ENVIRONMENT • ENERGY •

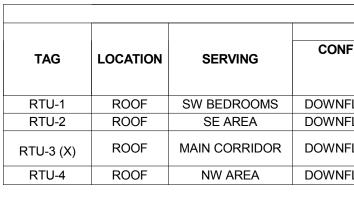

NOTES: 1. UNIT TO BE IECC 2015 COMPLIANT.


2, PROVIDE UNIT-WITH MERK & FILTER

CONTROLS NOTES TO BE COORDINATED BETWEEN EQUIPMENT MANUFACTURER AND CONTROLS CONTRACTOR AS REQUIRED. 3. CONFIGURE INPUT 3 AS THE COMPRESSOR SAFETY. 4. PROVIDE INPUT 4 AS THE SAFETY CHAIN ALARM. SHUTDOWN TO THE EXISTING FIRE ALARM CONTROL PANEL. 6. PROVIDE INPUT 8 AS THE ENTHALPY SWITCH. 7. PROVIDE INPUT 9 AS THE ICG OVERRIDE AS THIS IS REQUIRED FOR A GAS-FIRED RTU. 8.PROVIDE THE SPACE SENSOR AS THE COMMUNICATING RNET TYPE SENSOR. PROVIDE THE ZS PRO SENSOR. 9. PROVIDE FAN STATUS AS A SEPARATE POINT TIED TO AN ALC BAS PANEL AS THERE ARE NO FREE INPUTS ON THE RTU OPEN BOARD. PROVIDE AS AN INTRINSIC INPUT IF SUPPORTED BY RTU OPEN CONTROLLER. 10. PROVIDE FILTER STATUS AS A SEPARATE POINT TIED TO AN ALC BAS PANEL AS THERE ARE NO FREE INPUTS ON THE RTU OPEN BOARD. PROVIDE AS AN INTRINSIC INPUT IF SUPPORTED BY RTU OPEN CONTROLLER. 12.CONFIGURE MINIMUM DAMPER POSITION SO IT CAN BE OVERRIDDEN BY THE IAQ ROUTINE. 13. PROVIDE THE ECONOMIZER OPTION.

14. CONFIGURE THE OPTIMAL START OPTION.

											PACKAGEL				SCHEDULE (DA SPLII)				
			FAN			COOLING F	REFRIGERANT	INDOC	OR EQUIF	PMENT	OUTDOC	R EQUIF	PMENT					AC-01	CU-01	
TAG	LOCATION					CAPACITY		(A	AC-1 & 2)			U-1 & 2)		PRE-	MOTOR	DISC.	REMOTE	UNIT	UNIT	MANUFACTURER
		CFM E	SP	HP	MODE		TYPE	V/PH/HZ	FLA./	MCA	X/PH/HZ	MCA	MOCP	WIRED	STARTER	SWITCH/	CONTROL	WEIGHT	WEIGHT	AND
		((IN)			Ŷ	Ŷ	Ŷ	Ŷ	Ŷ	Ŷ		Ŷ	Y/N	Y/N	YŽN	DEVICES	(LBS.)	(LBS.)	
AC-1 & 2 CU-1 & 2	IT ROOM	775 N	N/A	N/A	COOLING ONZY	24,000	R-410A	208/1/60	1	1	208/1/60	20	30	Y	Y	Y	T-STAT	53	151	INDOOR - MITSUBISHI -PKA-A24KA7 HIGH WALL DISCHAF OUTDOOR - MITSUBISHI- PUY-A24NHA7- COOLING ONL
NOTES:													\smile	\checkmark	\sim	\sim	\sim	\sim	\sim	M M M M M M M M M M M M M M M M M M M
													\sim							

1. PROVIDE INDOOR UNIT WITH REMOTE MOUNTED THERMOSTAT, DISCOMMENT SWITCH AND CEILING MOUNTING HARDWARE - 2. PROVIDE OUTDOOR UNIT WITH MOUNTING BASE, BRACKETS, WIND BAFFLE, LOW AMBIENT KIT AND DISCONNECT SWITCH. \bigvee 3. PROVIDE UNITS WITH BACNET/ AND ONE BACNET MASTER GATEWAY AS REQUIRED TO INTERFACE TO BOTH UNITS AND EXISTING BAS. OWNER WILL PROVIDE NECESSARY IP DROP(S). LOCATE DEVICE WITHIN THE IT ROOM. 4. ALLOW FOR 2 HOURS OF ON-SITE COMMISSIONING

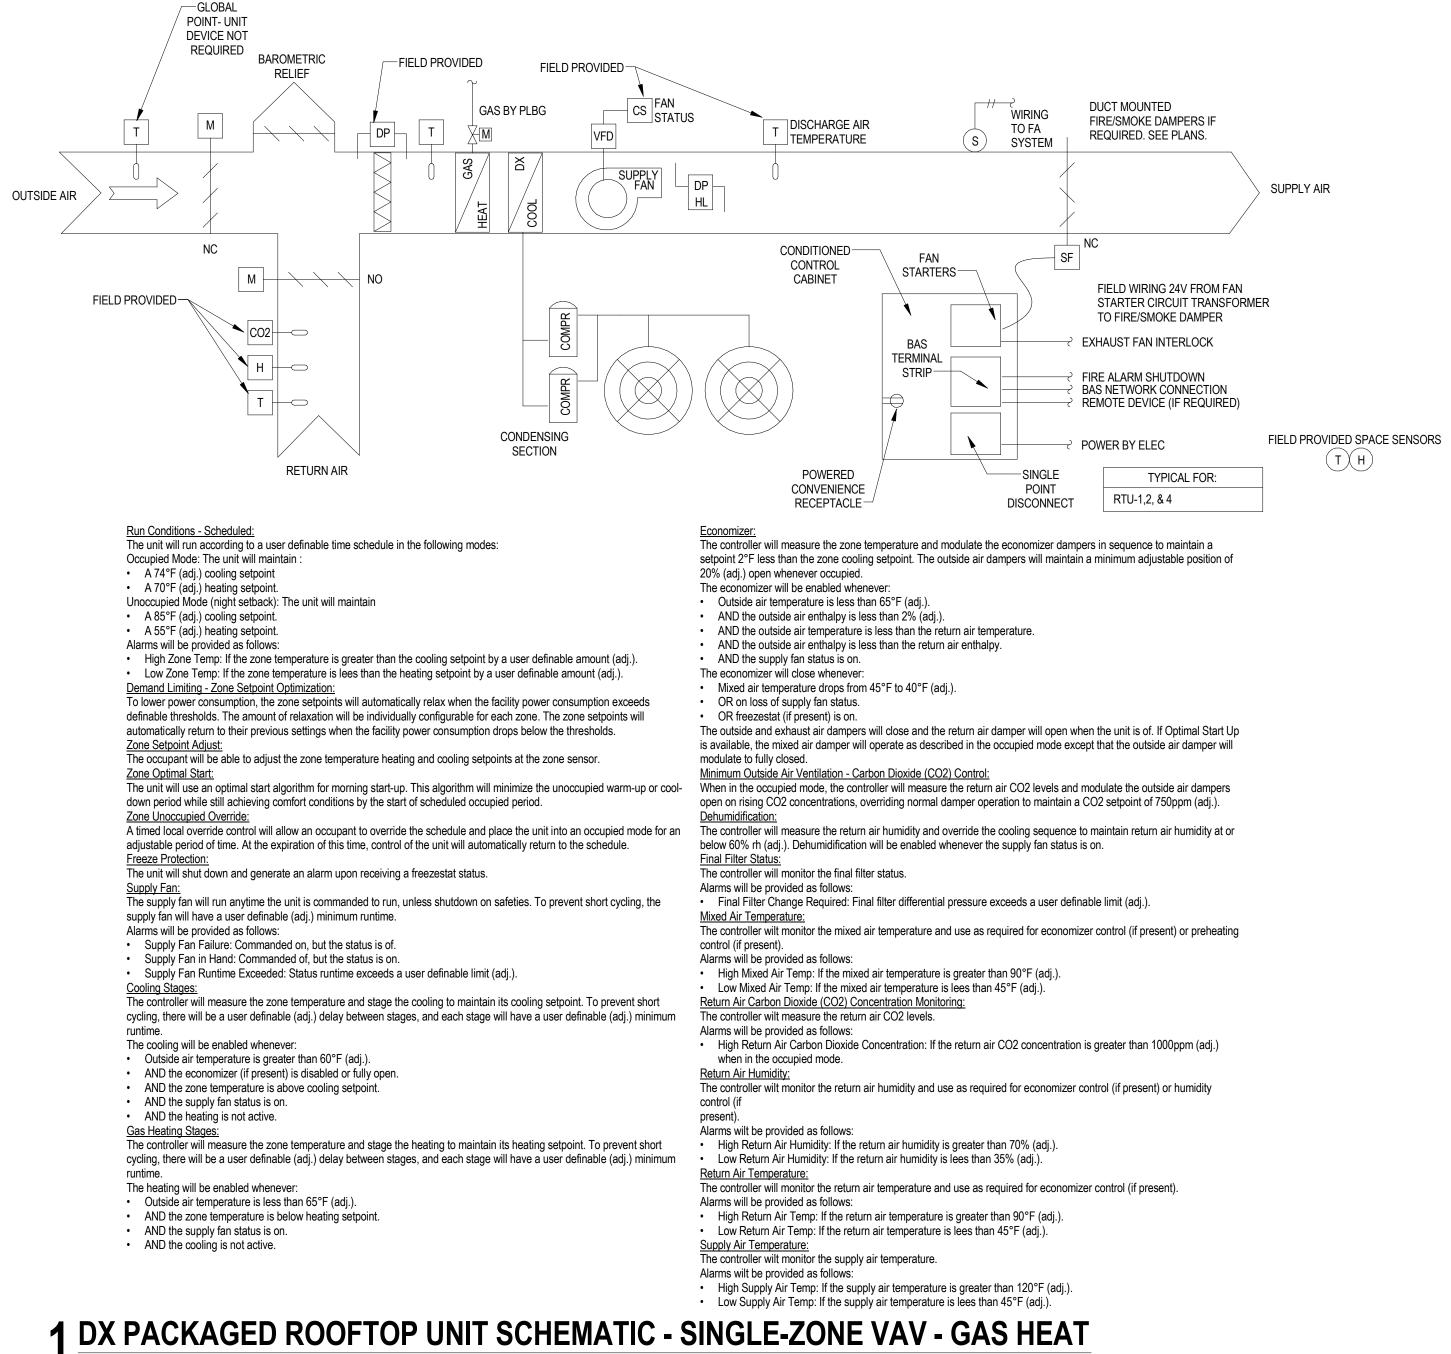

																ROOFTO	P UNIT SC	HEDULE																			
							ę	SUPPLY FA	N										0001											UNIT I	ELECTR	ICAL DAT	Γ Α				
ONFIG	TYPE	NOM.	-			COC	OLING I	HEATING	OUTSID	E AIRFLOW		FAN	M	DTOR D	ΑΤΑ	FILTER			COOL	ING CAP					HEATIN	G CAPACITY						DI	ISC. F	PRE-	UNIT		NOTES
		TONS	S TYP	PE AF	IEER	AIR		AIRFLOW	MIN	MAX	ESP	SPEED				SPECS	COMP	OAT (°F)	MAT	(°F) L	.AT (°F)	TOTAL	SENSIBLE	HEAT	1S/2S IN	1S/2S OUT	CONTROL	V/PH/HZ	FLA N	ICA MO		FD SWI	лтсн и	VIRED \	WEIGHT	BASIS OF DESIGN	NOTES
				EE	R		CFM)		(CFM)	(CFM)	(IN-WC)	(RPM)	HP	BHP	DRIVE	37203	TYPE	DB WB	DB	WB D	B WB	(MBH)	(MBH)	TYPE	(MBH)	(MBH)	CONTROL				(Y	/N) (Y	Y/N) ((Y/N)	(LB)		
/NFLOW	SZVAV	6	DX	X 1:	20.5	2	2450	2450	230	2450	1	833	1.5	1.29	BELT	NOTE 2	SCROLL	92.3 75.5	78.4	66.6 57	.2 56.9	74.9	56.0	NG	90/125	73/103	STAGED	208/3/60	41	39 50) '	Y	Y	Y	1232	CARRIER - 48LCR	ALL
/NFLOW	SZVAV	6	DX	X 1:	20.5	2	2000	2000	300	2000	1	794	1.25	0.97	BELT	NOTE 2	SCROLL	92.3 75.5	79.2	68 56	5.3 56.3	74.5	49.5	NG	90/125	73/103	STAGED	208/3/60	41	39 50) '	Y '	Y	Y	1232	CARRIER - 48LCR	ALL
/NFLOW	SZVAV	5	DX	× -	-		-	-	-	-	-	-	-	-	-	-	-		-			-	-	NG	-	-	-	208/3/60	-			-	-	-	-	EXISTING UNIT TO REMAIN (SHOWN FOR REFERENCE)	NONE
/NFLOW	SZVAV	7.5	DX	X 12	8 19.4	2	2825	2825	210	2825	1	717	2	1.70	BELT	NOTE 2	SCROLL	92.3 75.5	78.1	65.1 55	5.7 54.5	90.6	68.2	NG	120/150	96/120	STAGED	208/3/60	51	48 60) (Y '	Y	Y	1854	CARRIER - 48LCR	ALL

3. PROVIDE THRU THE BASE EVECTRICAL VEACTORY MOUNTED DISCONNECT SWITCH AND POWERED CONVENTENCE OUTLET WITH UNIT 4. PROVIDE NEW 14" MOUNTING CURB AS REQUIRED PER MANUFACTURER'S RECOMMENDATION TO SUPPORT UNIT STRUCTURAL ON NEW I- BEAM OR STRUCTURAL PLATFORM.

ALC CONTROLLER TO PROVIDED IN LIEU OF CARRIER RTU OPEN CARD REFERENCED BELOW. FUNCTIONALITY TO REMAIN THE SAME. 1. CONTROLS CONTRACTOR TO PROVIDE THE FOLLOWING DEVICES IN ADDITION TO REQUIREMENTS LISTED BELOW:

UNIT CONTROLLER, WALL MOUNTED SPACE TEMP SENSOR, CO2, AND HUMIDITY SENSOR, DISCHARGE AIR TEMP SENSOR, DIRTY FILTER, AND FAN STATUS. 2. CONFIGURE INPUT 2 AS THE IAQ SENSOR. PROVIDE 24 VDC POWER FOR SENSOR. PROVIDE THE SENSOR THAT SUPPORTS DEMAND CONTROL VENTILATION.

5. PROVIDE INPUT 5 AS FIRE ALARM SHUTDOWN. CO-ORDINATE WITH SIMPLEX. ARRANGE WITH SIMPLEX TO PROVIDE FIRE ALARM

11. PROVIDE A SPACE RH SENSOR AS A SEPARATE POINT TIED TO AN ALC BAS PANEL AS THERE ARE NO FREE INPUTS ON THE RTU OPEN BOARD.

PROVIDE AS AN INTRINSIC INPUT IF SUPPORTED BY RTU OPEN CONTROLLER. ALC SHALL DETERMINE WHEN DEHUMIDIFICATION IS REQUIRED AND SHALL WRITE TO THE SYSTEM MODE MSV TO PUT THE UNIT INTO DEHUMIDIFICATION MODE. DEHUMIDIFICATION MODE IS ALLOWED WHEN OAT > 80 AND RH IS ABOVE 50%.

PACKAGED AIR CONDITIONI	NG UNIT S	SCHEDULE ((DX SPLIT)

	VER BY ELEC	T H
	TYPICAL FOR:	
POINT CONNECT	RTU-1,2, & 4	
		-

ZONE	DOOM					DEFAULT OCC.		# 05			SUPPLY AIRFLOW		EXHAUST AIRFLOW	EXHAUST AIRFLOW		
ROOM NAME	ROOM NUMBER	ROOM FUNCTION	AREA (SF)	AIRFLOW RATE (CFM/PERSON)	AIRFLOW RATE (CFM/SF)	DENSITY (#/1000 SF)	DEFAULT # OF OCC.	# OF OCC.	REQUIRED (CFM)	PROVIDED (CFM)	PROVIDED (CFM)	EXHAUST AIRFLOW RATE (CFM/TOILET)	REQUIRED (CFM)	PROVIDED (CFM)	SYSTEM	NOTES
S CORRIDOR		CORRIDOR	905	0	0.06	0	0	0	54	55	780				RTU-1	
SE-BREAKROOM		BREAK ROOMS (GENERAL)	125	5	0.06	25	3	2	18	20	250				RTU-1	
SW-BEDROOM	01706	DWELLING UNIT	175	5	0.06	2	0	2	21	25	220				RTU-1	
SW-RESTROOM	1	TOILETS	35	0	0.00	0	0	0	0	0	0	25	25	25	EF-(X)	
SW-BEDROOM	01707	DWELLING UNIT	201	5	0.06	2	0	2	22	25	220				RTU-1	
SW-BEDROOM	01708	DWELLING UNIT	201	5	0.06	2	0	2	22	25	220				RTU-1	
SW-RESTROOM	2	TOILETS	35	0	0.00	0	0	0	0	0	0	25	25	25	EF-(X)	
SW-BEDROOM	01709	DWELLING UNIT	216	5	0.06	2	0	2	23	25	220				RTU-1	
SW-BEDROOM	01710	DWELLING UNIT	175	5	0.06	2	0	2	21	25	220				RTU-1	
SW-RESTROOM	3	TOILETS	35	0	0.00	0	0	0	0	0	0	25	25	25	EF-(X)	
SW-BEDROOM	01711	DWELLING UNIT	195	5	0.06	2	0	2	22	25	220				RTU-1	
SE-ENTRY	1	CORRIDOR	55	0	0.06	0	0	0	3	5	100				RTU-1	
COMPUTER LAB	01705	COMPUTER LAB	470	5	0.06	4	2	14	98	100	680				RTU-2	
ENTERTAINMENT ROOM	01704	MULTI-PURPOSE	470	5	0.06	120	56	14	98	100	680				RTU-2	
CAFÉ	01703	DAY ROOM	360	5	0.06	30	11	14	92	100	680				RTU-2	
SW-OFFICE	1	OFFICE SPACE	77	5	0.06	5	1	1	10	10	100				RTU-3 (X)	
SW-CLOSET	2	ELEC/ MECH EQPT ROOM	76	5	0.00	0	1	0	0	0	0				EF-(X)	
C-OFFICE	01141	OFFICE SPACE	95	5	0.06	5	1	1	11	15	100				RTU-3 (X)	
MAIN CORRIDOR		CORRIDOR	380	0	0.06	0	2	0	23	25	575				RTU-3 (X)	
NW-OFFICE	1	OFFICE SPACE	76	5	0.06	5	1	1	10	10	100				RTU-3 (X)	
NW-CLOSET	2	ELEC/ MECH EQPT ROOM	77	5	0.00	0	1	0	0	0	0				EF-(X)	
RESTROOM	01140	TOILETS	48	0	0.00	0	0	1	0	0	50	50	50	50	EF-(X)/RTU-3 (X)	
EXAM ROOM	01139	OFFICE SPACE	122	5	0.06	5	1	1	12	15	125				RTU-3 (X)	
C-ENTRY	01102	CORRIDOR	90	0	0.06	0	0	0	5	5	50				RTU-3 (X)	
NE-WRS OFFFICE	01143	OFFICE SPACE	662	5	0.06	5	3	4	60	55	900				RTU-3 (X)	
NE-RESTROOM	01144	TOILETS	44	0	0.00	0	0	0	0	0	50	50	50	50	EF-(X)	
NE-RESTROOM	01145	TOILETS	45	0	0.00	0	0	0	0	0	75	50	50	50	RTU-4/EF-(X)	
NORTH CORRIDOR		CORRIDOR	865	0	0.06	0	0	0	52	55	550				RTU-4	
NW OFFICE	01508	OFFICE SPACE	444	5	0.06	5	2	4	47	50	700				RTU-4	
NW OFFICE	01506B	OFFICE SPACE	74	5	0.06	5	0	1	9	10	200				RTU-4	
NW OFFICE	7	OFFICE SPACE	104	5	0.06	5	1	1	11	15	100				RTU-4	
NW OFFICE	01506	OFFICE SPACE	388	5	0.06	5	2	4	43	45	700				RTU-4	
NE-RESTROOM	01509A	TOILETS	93	0	0.00	0	0	0	0	0	150	50	50	75	RTU-4/EF-(X)	
NE-STORAGE	01509	STORAGE ROOM	84	0	0.12	0	0	0	10	10	75		-	-	RTU-4	
NE-OFFICE	01507	OFFICE SPACE	210	5	0.06	5	1	2	23	25	350				RTU-4	
IT ROOM	1505	ELEC/ MECH EQPT ROOM	290	5	0.00	0	0	0	0	0	0				AC 1 & 2	

15. PROVIDE DEMAND CONTROL VENTILATION CONTROL OPTION. 16. CONFIGURE NIGHT TIME FREE COOLING OPTION. 17. CONFIGURE THE COMPRESSOR RUNTIME ALARM. 18. PROVIDE THE WALL MOUNTED SYSTEM TOUCH DISPLAY. CONNECT THE DISPLAY TO THE BACNET MS/TP NETWORK. 18.PROVIDE AND CONFIGURE THE FDD OPTION.

5. GAS CONNECTION TO BE AT ROOF LEVEL.

19. ALC SHALL PROVIDE A DWYER A-306 OR APPROVED EQUAL OUTDOOR STATIC AIR PRESSURE SENSOR TO READ BUILDING STATIC PRESSURE. STATIC PRESSURE CONTROL IS NOT PART OF THE WORK BASED ON THE DRAWINGS.

20. ALC SHALL ALLOW FOR PROVIDING ALL THE TYPICAL ALARMS SHOWN IN RTU OPEN PROTOCOL TABLE 4 THAT COME WITH THE UNIT. 21.ALC SHALL ALLOW FOR 50 TRENDS PER RTU CONFIGURED AS 15 MINUTE TRENDS THAT ARE STORED ON THE LAKE COUNTY SERVER FOR 90 DAYS.

ALLOW FOR 5 LONG TERM CRITICAL 15 MINUTE TRENDS THAT HAVE NO EXPIRY. 22. ALC SHALL PROVIDE A CURRENT TRANSDUCER TO MEASURE THE KWH FOR EACH RTU. CREATE A 24 TREND OF THE TOTAL KWH CONSUMED.

EXPOSE THIS TREND VIA BACNET SO THIS VALUE CAN BE ADDED TO THE ENERGY MONITORING SYSTEM. 23. LAKE COUNTY WILL PROVIDE BACNET CONFIGURATION INFORMATION SUCH AS DEVICE OBJECT NAME AND INSTANCE.

24. COMPLETE THE STARTUP SHEET TESTS AS PART OF THE COMMISSION WORK WITH THE LAKE COUNTY BAS CONSULTANT. 25. PROVIDE THE SERVICE TEST FUNCTION AS PART OF THE RTU FIELD STARTUP. PROVIDE REPORT TO OWNER.

6. PROVIDE STAINLESS STEEL HX AND POLYMER DRAIN PAN.

7. PROVIDE SUPPLY SMOKE DETECTOR (COORDINATE WITH SIMPLEX) AND HAIL GUARDS. 8. PROVIDE WITH ENTHALPY CONTROLLED ECONOMIZER, BAROMETRIC RELIEF, LOW LEAK DAMPERS.

9. PROVIDED FACTORY INSTALLED ALC SE6104A (OR APPROVED EQUAL) IN LIEU OF CARRIER RTU OPEN CARD PROVIDED THAT THE SCOPE OF WORK IN THESE DRAWINGS NOTES AND THE SEQUENCE OF OPERATIONS IS FULLY MET BY USING AN ALC BACNET MS/TP CONTROLLER.

					А	IR DEVICE SC	HEDULE				
REMARKS	TAG	SERVICE	TYPE	MOUNT.	CFM	MODULE SIZE	NECK SIZE	OBD (Y/N)	MATERIAL	BASIS OF DESIGN	NOTES
					1-120		Ø6"				
					125-250		Ø8"				
	A	SUPPLY	DIFFUSER	CEILING	255-450	24"x24"	Ø10"	Y	STEEL	TITUS TMS	1-6
					455-550		Ø12"				
1 al al					555-700		Ø14"				
	A	SUPPLY	DIFFUSER	CEILING	1-120	12"x12"*	Ø6"	Y	STEEL	TITUS TMS	1-6
		JOFFEI	DITTUSER	CLILING	125-250	12 X12	Ø8"	I	SILL	11103 1113	1-0
	в	RETURN/ EXHAUST/	DIFFUSER	CEILING	1-100	12"x12"*	Ø6"	Y	STEEL	TITUS PAR	2-6
		TRANSFER	DITTUSER	CEIEING	105-350	12 112	10"X10"	I	STELL	11031 AK	2-0
	B	RETURN/ EXHAUST/ TRANSFER		CEILING	1-100 105-190 195-300 305-450	24"x24"*	Ø6" Ø8" Ø10" Ø12"	~~	STEEL		2-6
	C C	SUPPLY	DIFFUSER	SIDEWALL	SEE PLANS	MATCH EXISTING	N/A	Y	STEEL	TITUS 350RL	2-6

1. PROVIDE WITH FOIL BACKED INSULATION OPTION FOR ALL SUPPLY DIFFUSERS AS AVAILABLE. 2. COORDINATE DIFFUSER MODULE SIZE, 3 OR 4 WAY WITH EXISTING SUPPLY/RETURN DIFFUSERS. MATCH EXISTING FOR FINISH AND COLOR UNLESS DIRECTED OTHERWISE. ALL EXISTING DIFFUSERS IN SCOPE OF WORK TO BE REPLACED IN KIND. 3. TOTAL STATIC PRESSURE SHALL NOT EXCEED 0.10" WG FOR ALL DIFFUSERS, GRILLES AND REGISTERS, 0.05" WG FOR ALL TRANSFER GRILLES AND LOUVERS.

4. PROVIDE INTEGRAL BALANCING DEVICE FOR ALL REGISTERS, DIFFUSERS, GRILLES UNLESS NOTED OTHERWISE.

5. UNLESS OTHERWISE INDICATED, DUCTS CONNECTING AIR DEVICES SHALL MATCH AIR DEVICE NECK. 6. CONTRACTOR TO COORDINATE FRAME, BORDER AND MOUNTING HARDWARE TO INSTALL IN EXISTING CEILING

OR NEW CEILING AS REQUIRED.

VENTILATION SCHEDULE

	LDINGS • EARTH & ENVIRONMENT • EI STRIAL • INFRASTRUCTURE • SUSTAIN	
THIS REPRODU NO RESPONSII STRICTLY PRO RESPONSIBILI	NOT SCALE DRAWINGS. JCTION MAY BE AT A SIZE DIFFERENT THAN ORIGINALLY DRAWN. BILITY FOR INCORRECT SCALING. UNAUTHORIZED REPRODUCTIO HIBITED. NOT PUBLISHED - ALL RIGHTS RESERVED. EXP EXPRES IY ARISING FROM UNAUTHORIZED USE OF THESE DRAWINGS AND IN MUST BE IN WRITING.	N OR REUSE IS SLY DISCLAIMS
© exp, 2012		
	ENDUM #1	06-29-2018
No.	Revision	Date
	ISSUED FOR BID	
Professiona	I Seal(s)	
Drawn By:	AJJ	
Checked By Approved B		
Date Printed		
File Name: Project Title	CHI-00240054-A1.rfa	
	Robert W. Depke	
Jι	venile Justice Comp RTU Replacement	
	24647 N Milwaukee Ave, Vernon Hills, IL 60061	
Dwg. Title		
	MECHANICAL	
	SCHEDULES	
Project No.		
Dwg. No.	CHI-00240054-A1	No.
	M601	1

exp U.S. Services Inc.

Chicago, IL 60601

ww.exp.com

+1.312.616.0000 f: +1.312.616.6069 205 North Michigan Avenue, Suite 3600

STRUCTURAL GENERAL NOTES

GENERAL:

DEVIATION.

- 1. THE PRIMARY PURPOSE OF THE CONTRACT DRAWINGS IS FOR BIDDING AND PERMITTING. THE CONTRACTOR SHALL FOLLOW THE CONTRACT DRAWINGS, THE CONTRACT SPECIFICATONS, AND THE REQUIRED PROJECT SUBMITTALS FOR COMPLETION OF THE PROJECT.
- DETAILS AND SECTIONS NOTED AS TYPICAL SHALL BE CONSTRUED TO APPLY TO TYPICAL CONDITIONS ELSEWHERE.
- DETAILS AND SECTIONS NOTED AS SIMILAR SHALL BE CONSTRUED AS SIMILAR TO THE REFERENCE DETAIL/SECTION AT THE LOCATION INDICATED.
- THE CONTRACTOR SHALL FIELD CHECK AND VERIFY ALL EXISTING CONDITIONS AND 4. REPORT ANY DISCREPANCIES TO THE OWNER'S REPRESENTATIVE BEFORE
- PROCEEDING WITH THE WORK. DO NOT SCALE THE DRAWINGS, USE DIMENSIONS. 5.
- NO CHANGE IN SIZE OR DIMENSION OF ANY STRUCTURAL ELEMENT SHALL BE MADE WITHOUT PRIOR WRITTEN APPROVAL OF THE STRUCTURAL ENGINEER.
- NO OPENINGS SHALL BE MADE IN ANY STRUCTURAL ELEMENT UNLESS SPECIFICALLY INDICATED ON THE CONTRACT DRAWINGS OR IF PRIOR WRITTEN APPROVAL FROM THE STRUCTURAL ENGINEER HAS BEEN PROVIDED.
- THE STRUCTURE IS DESIGNED TO FUNCTION AS A UNIT UPON COMPLETION. AS A RESULT OF THE CONSTRUCTION MEANS, METHODS, AND/OR SEQUENCES OF CONSTRUCTION CHOSEN BY THE CONTRACTOR, THE CONTRACTOR SHALL BE RESPONSIBLE FOR DESIGNING AND FURNISHING ALL TEMPORARY BRACING AND/OR SUPPORT THAT MAY BE REQUIRED TO MAINTAIN STRUCTURAL INTEGRITY DURING
- CONSTRUCTION. THE CONTRACTOR SHALL INFORM THE CONSTRUCTION MANAGER OR THE OWNER'S ON-SITE REPRESENTATIVE IN WRITING OF ANY DEVIATION FROM THE CONTRACT DOCUMENTS. THE CONTRACTOR SHALL NOT BE RELIEVE OF THE RESPONSIBILITY FOR SUCH DEVIATION BASED UPON THE REVIEW OF PROJECT SUBMITTALS UNLESS THE CONTRACTOR SPECIFICALLY INFORMED THE CONSTRUCTION MANAGER OR OWNER'S ON-SITE REPRESENTATIVE OF SUCH DEVIATION AT THE TIME OF SUBMISSION, AND THE CONSTRUCTION MANAGER HAS GIVEN WRITTEN APPROVAL FOR THE SPECIFIC

STRUCTURAL STEEL: (AISC 303-10).

- 21, 2009. UNLESS OTHERWISE NOTED, ALL BOLTED CONNECTIONS SHALL BE MADE WITH 0.75 INCH
- ALLOWED TO BE INCLUDED IN THE SHEAR PLANE, CONFORMING TO ASTM A325-N. ALL WELDED CONNECTIONS FOR STRUCTURAL STEEL SHALL CONFORM TO THE LATEST
- EDITION OF THE AWS STRUCTURAL WELDING CODE D.1.1. UNLESS OTHERWISE NOTED, ALL WELDED CONNECTIONS SHALL BE MADE WITH E70 ELECTRODES.
- DETAILS IN THE STRUCTURAL STEEL SUBMITTAL ACCORDING TO THE PROJECT SPECIFICATIONS. 6. ALL STRUCTURAL STEEL TO BE HOT DIPPED GALVANIZED.

CONCRETE AND CONCRETE ACCESSERIES:

- MINIMUM CONCRETE COMPRESSIVE STRENGTH (f'c) AT 28 DAYS SHALL BE: FOOTINGS, FOUNDATION WALLS, AND GRADE BEAMS
- THE MINIMUM CONCRETE COMPRESSIVE STRENGTH SHALL BE VERIFIED BY FIELD QUALITY CONTROL IN ACCORDANCE WITH THE CAST-IN-PLACE CONCRETE SPECIFICATION.
- ALL CONCRETE SHALL BE READY MIXED, JOB MIXED CONCRETE IS NOT PERMITTED.
- ALL CONCRETE SHALL BE NORMAL WEIGHT UNLESS NOTED OTHERWISE. 4
- SEE SPECIFICATIONS FOR ENTRAINED AIR REQUIREMENTS. SEE SPECIFICATIONS AND ARCHITECTURAL DRAWINGS FOR CONCRETE FINISH
- REQUIREMENTS INCLUDING SURFACE HARDNERS AND SEALERS. THE MINIMUM YIELD STRENGTH (fy) OF BOTH DEFORMED BAR AND PLAIN WIRE
- REINFORCEMENT SHALL BE 60,000 PSI. UNLESS OTHERWISE NOTED ON THE DRAWINGS, THE PROTECTION OF CONCRETE
- REINFORCEMENT (NON-PRESTRESSED) SHALL ADHERE TO SECTION 7.7.1 OF ACI 318. THE FOLLOWING DIMENSIONS ARE IN INCHES. CONCRETE CAST AGAINST AND PERMANENTLY EXPOSED TO EARTH 3 CONCRETE EXPOSED TO EARTH OR WEATHER

NO. 6 BAR THROUGH NO. 18 BAR NO. 5 BAR, W31 OR D31 WIRE, AND SMALLER

- NO. 14 AND NO. 18 BARS NO. 11 BAR AND SMALLER
- WHEN THE DRAWINGS GRAPHICALLY INDICATE A 90 OR 180 DEGREE HOOK, PROVIDE A STANDARD HOOK IN ACCORDANCE WITH SECTION 7.1 OF ACI 318.
- WHEN THE DRAWINGS GRAPHICALLY INDICATE TENSION REINFORCMENT AS LAPPED, USE A CLASS B TENSION SPLICE IN ACCORDANCE WITH SECTION 12.15 OF ACI 318. MECHANICAL SPLICES ARE PERMITTED AND SHALL DEVELOPED A MINIMUM OF 1.25(fy) OF THE BAR.
- WHEN THE DRAWINGS INDICATE A BOND BREAKER, PROVIDE A 30LB ASPHALT SATURATED FELT, TYPE II, CONFORMING TO ASTM D226.

ALL DETAILING, FABRICATION, AND ERECTION OF STRUCTURAL STEEL SHALL CONFORM TO THE AISC CODE OF STANDARD PRACTICE FOR STEEL BUILDINGS AND BRIDGES, 2010 EDITION

ALL BOLTED CONNECTIONS FOR STRUCTURAL STEEL FRAMING SHALL CONFORM TO THE AISC SPECIFICATION FOR STRUCTURAL JOINTS USING HIGH-STRENGTH BOLTS, DATED DECEMBER

DIAMETER HIGH STRENGTH BOLTS, BEARING TYPE, SNUG TIGHTENED, WITH THREADS

STRUCTURAL STEEL CONNECTION DETAILS INDICATED ON THE DRAWINGS SHALL NOT BE USED FOR FABRICATION. THE FABRICATOR SHALL VERIFY THE GEOMETRY AND INCLUDE THE

4000 PSI

1-1/2 CONCRETE NOT EXPOSED TO WEATHER OR IN CONTACT WITH THE GROUND 1-1/2 3/4

 
FOUNDATIONS:

- FOUNDATION DESIGN: ALLOWABLE BERAING PRESSURE FOR CONTINUOUS AND SPREAD FOOTINGS = 2000 PSF
- FOUNDATION DESIGNS ARE BASED UPON CODE PERMITTED PRESUPTIVE SOIL LOAD BEARING VALUES. BOTTOM OF ALL FOUNDATION SHALL BE INSPECTED BY A REGISTERED SOILS ENGINEER AND DESIGN BEARING CAPACITY VERFIED BEFORE PLACING ANY CONCRETE.
- BACKFILL FOR FOUNDATION ELEMENTS SHALL BE MADE OF SOIL THAT IS FREE OF ORGANIC MATERIAL, CONSTRUCTION DEBRIS, COBBLES, AND BOULDERS. IN LIEU OF SOIL, CONTROLLED LOW STRENGTH MATERIAL (CLSM) CAN BE USED IF A WRITTEN REQUEST IS SUBMITTED TO THE CONSTRUCTION MANAGER OR ON-SITE OWNER'S REPRESENTATIVE AND APPROVED BY BOTH THE STRUCTURAL ENGINEER AND THE OWNER.

FOUNDATIONS:

2.

- FOUNDATION DESIGN: ALLOWABLE BERAING PRESSURE FOR CONTINUOUS AND 1. SPREAD FOOTINGS = 2000 PSF
- FOUNDATION DESIGNS ARE BASED UPON CODE PERMITTED PRESUPTIVE SOIL LOAD BEARING VALUES. BOTTOM OF ALL FOUNDATION SHALL BE INSPECTED BY A REGISTERED SOILS ENGINEER AND DESIGN BEARING CAPACITY VERFIED BEFORE PLACING ANY CONCRETE.
- BACKFILL FOR FOUNDATION ELEMENTS SHALL BE MADE OF SOIL THAT IS FREE OF 3. ORGANIC MATERIAL, CONSTRUCTION DEBRIS, COBBLES, AND BOULDERS. IN LIEU OF SOIL, CONTROLLED LOW STRENGTH MATERIAL (CLSM) CAN BE USED IF A WRITTEN REQUEST IS SUBMITTED TO THE CONSTRUCTION MANAGER OR ON-SITE OWNER'S REPRESENTATIVE AND APPROVED BY BOTH THE STRUCTURAL ENGINEER AND THE OWNER.



STRICTLY PROHIBITED. NOT PUBLISHED - ALL RIGHTS RESERVED. EXP EXPRESS RESPONSIBILITY ARISING FROM UNAUTHORIZED USE OF THESE DRAWINGS AND AUTHORIZATION MUST BE IN WRITING. © exp, 2012	SLY DISCLAIMS
1 ADDENDUM #1	06-29-2018
No. Revision	Date
ISSUED FOR BID	
Professional Seal(s)	
Drawn By: HG	
Checked By: DL	
Approved By: Approver	
Date Printed: 06.18.2018 File Name: CHI-00240054-A1.rfa	
Project Title	
Robert W. Depke Juvenile Justice Comp	ex
RTU Replacement	
24647 N Milwaukee Ave,	
Vernon Hills, IL 60061	
Dwg. Title	
	AL
Dwg. Title	AL
Dwg. Title STRUCTURAL GENER NOTES	AL
Dwg. Title STRUCTURAL GENER NOTES	
Dwg. Title STRUCTURAL GENER NOTES Project No. CHI-00240054-A1	


• BUILDINGS • EARTH & ENVIRONMENT • ENERGY • INDUSTRIAL • INFRASTRUCTURE • SUSTAINABILITY CAUTION: DO NOT SCALE DRAWINGS. THIS REPRODUCTION MAY BE AT A SIZE DIFFERENT THAN ORIGINALLY DRAWN. EXP ASSUMES NO RESPONSIBILITY FOR INCORRECT SCALING. UNAUTHORIZED REPRODUCTION OR REUSE IS STRICTLY PROHIBITED. NOT PUBLISHED - ALL RIGHTS RESERVED. EXP EXPRESSLY DISCLAIMS RESPONSIBILITY ARISING FROM UNAUTHORIZED USE OF THESE DRAWINGS AND NOTES. AUTHORIZATION MUST BE IN WRITING.

exp U.S. Services Inc.

Chicago, IL 60601

www.exp.com

t: +1.312.616.0000 f: +1.312.616.6069 205 North Michigan Avenue, Suite 3600

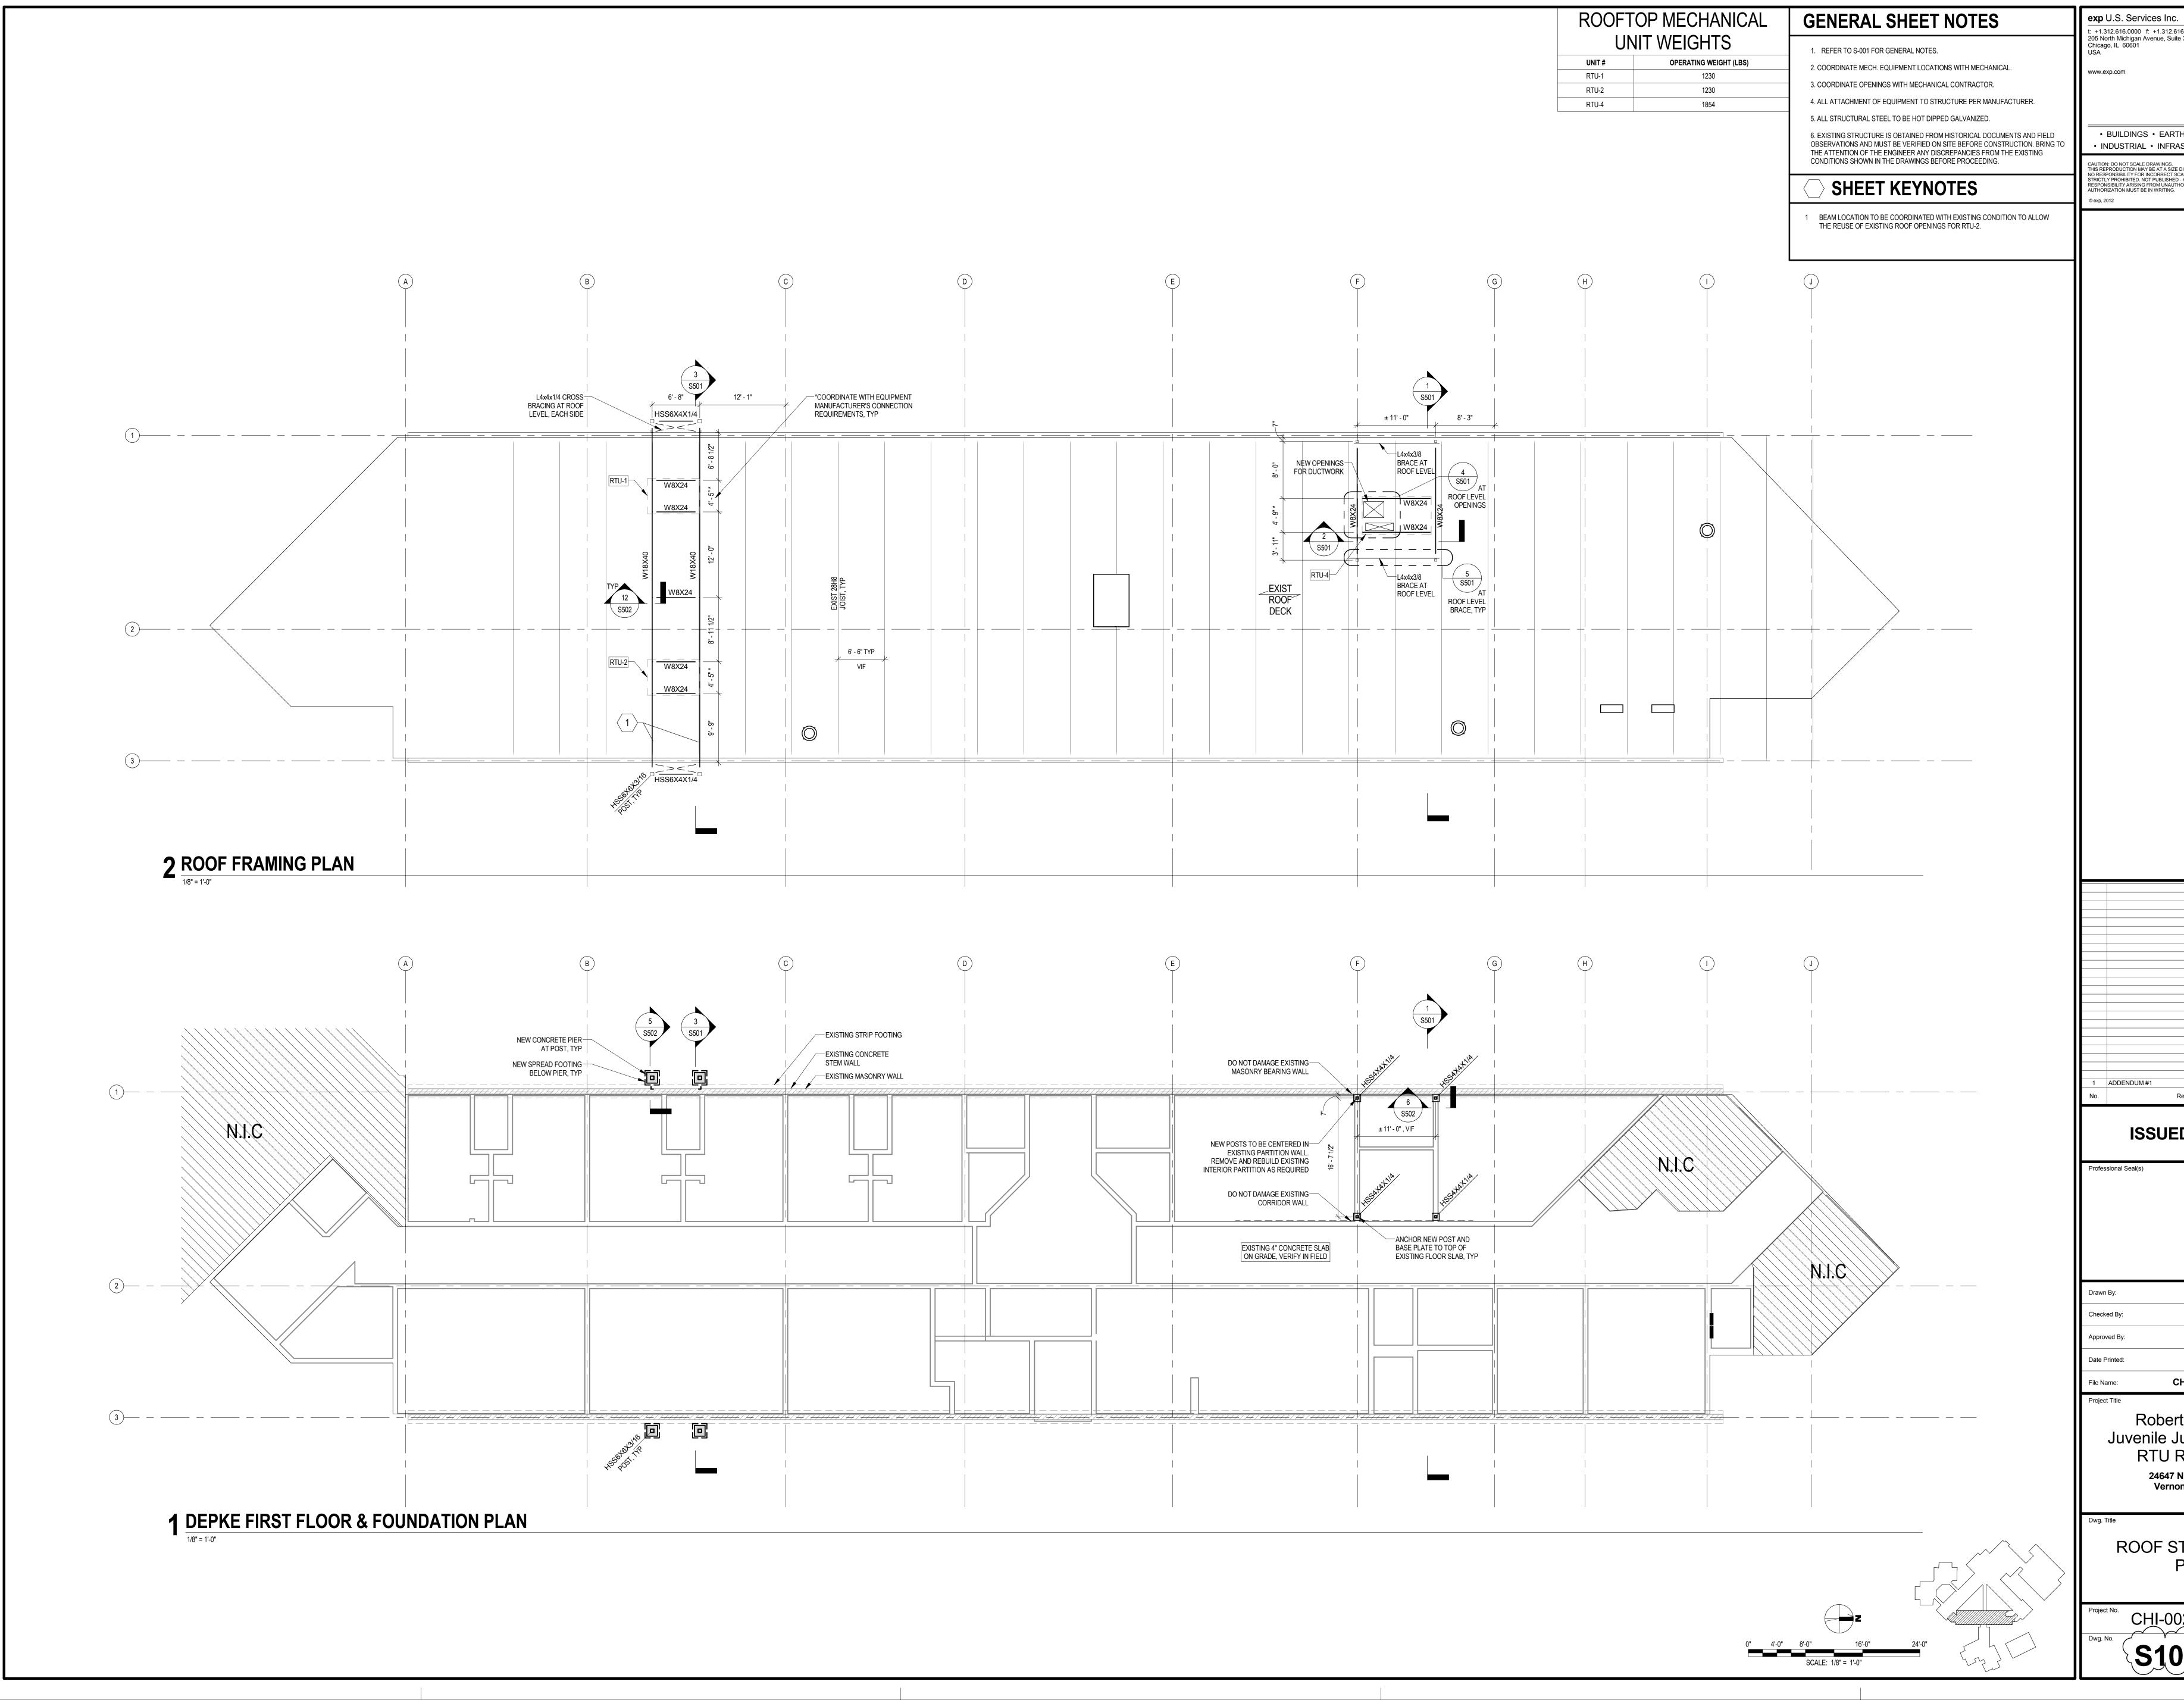


1 No.	ADDENDUM #1 Revision	06-29-2018 Date			
ISSUED FOR BID					
Profes	sional Seal(s)				
Drawn	By: Author				
Check	ed By: Checker				
Approv	Approver				
Date F	rinted: 06.18.2018				
File Na	me: CHI-00240054-A1.rfa				
Project Title					
	Robert W. Depke				
	Juvenile Justice Comp	ex			
	RTU Replacement				
24647 N Milwaukee Ave, Vernon Hills, IL 60061					
Vernon Hills, IL 60061					
Dwg.	ïtle				
ROOF STRUCTURAL					
PLAN					
Project No. CHI-00240054-A1					
Dwg. No.					
	S101 1				

 BUILDINGS • EARTH & ENVIRONMENT • ENERGY • INDUSTRIAL • INFRASTRUCTURE • SUSTAINABILITY AUTION: DO NOT SCALE DRAWINGS. HIS REPRODUCTION MAY BE AT A SIZE DIFFERENT THAN ORIGINALLY DRAWN. EXP ASSUMES O RESPONSIBILITY FOR INCORRECT SCALING. UNAUTHORIZED REPRODUCTION OR REUSE IS TRICTLY PROHIBITED. NOT PUBLISHED - ALL RIGHTS RESERVED. EXP EXPRESSLY DISCLAIMS ESPONSIBILITY ARISING FROM UNAUTHORIZED USE OF THESE DRAWINGS AND NOTES. UTHORIZATION MUST BE IN WRITING.

t: +1.312.616.0000 f: +1.312.616.6069 205 North Michigan Avenue, Suite 3600 Chicago, IL 60601 USA www.exp.com

xp, 2012

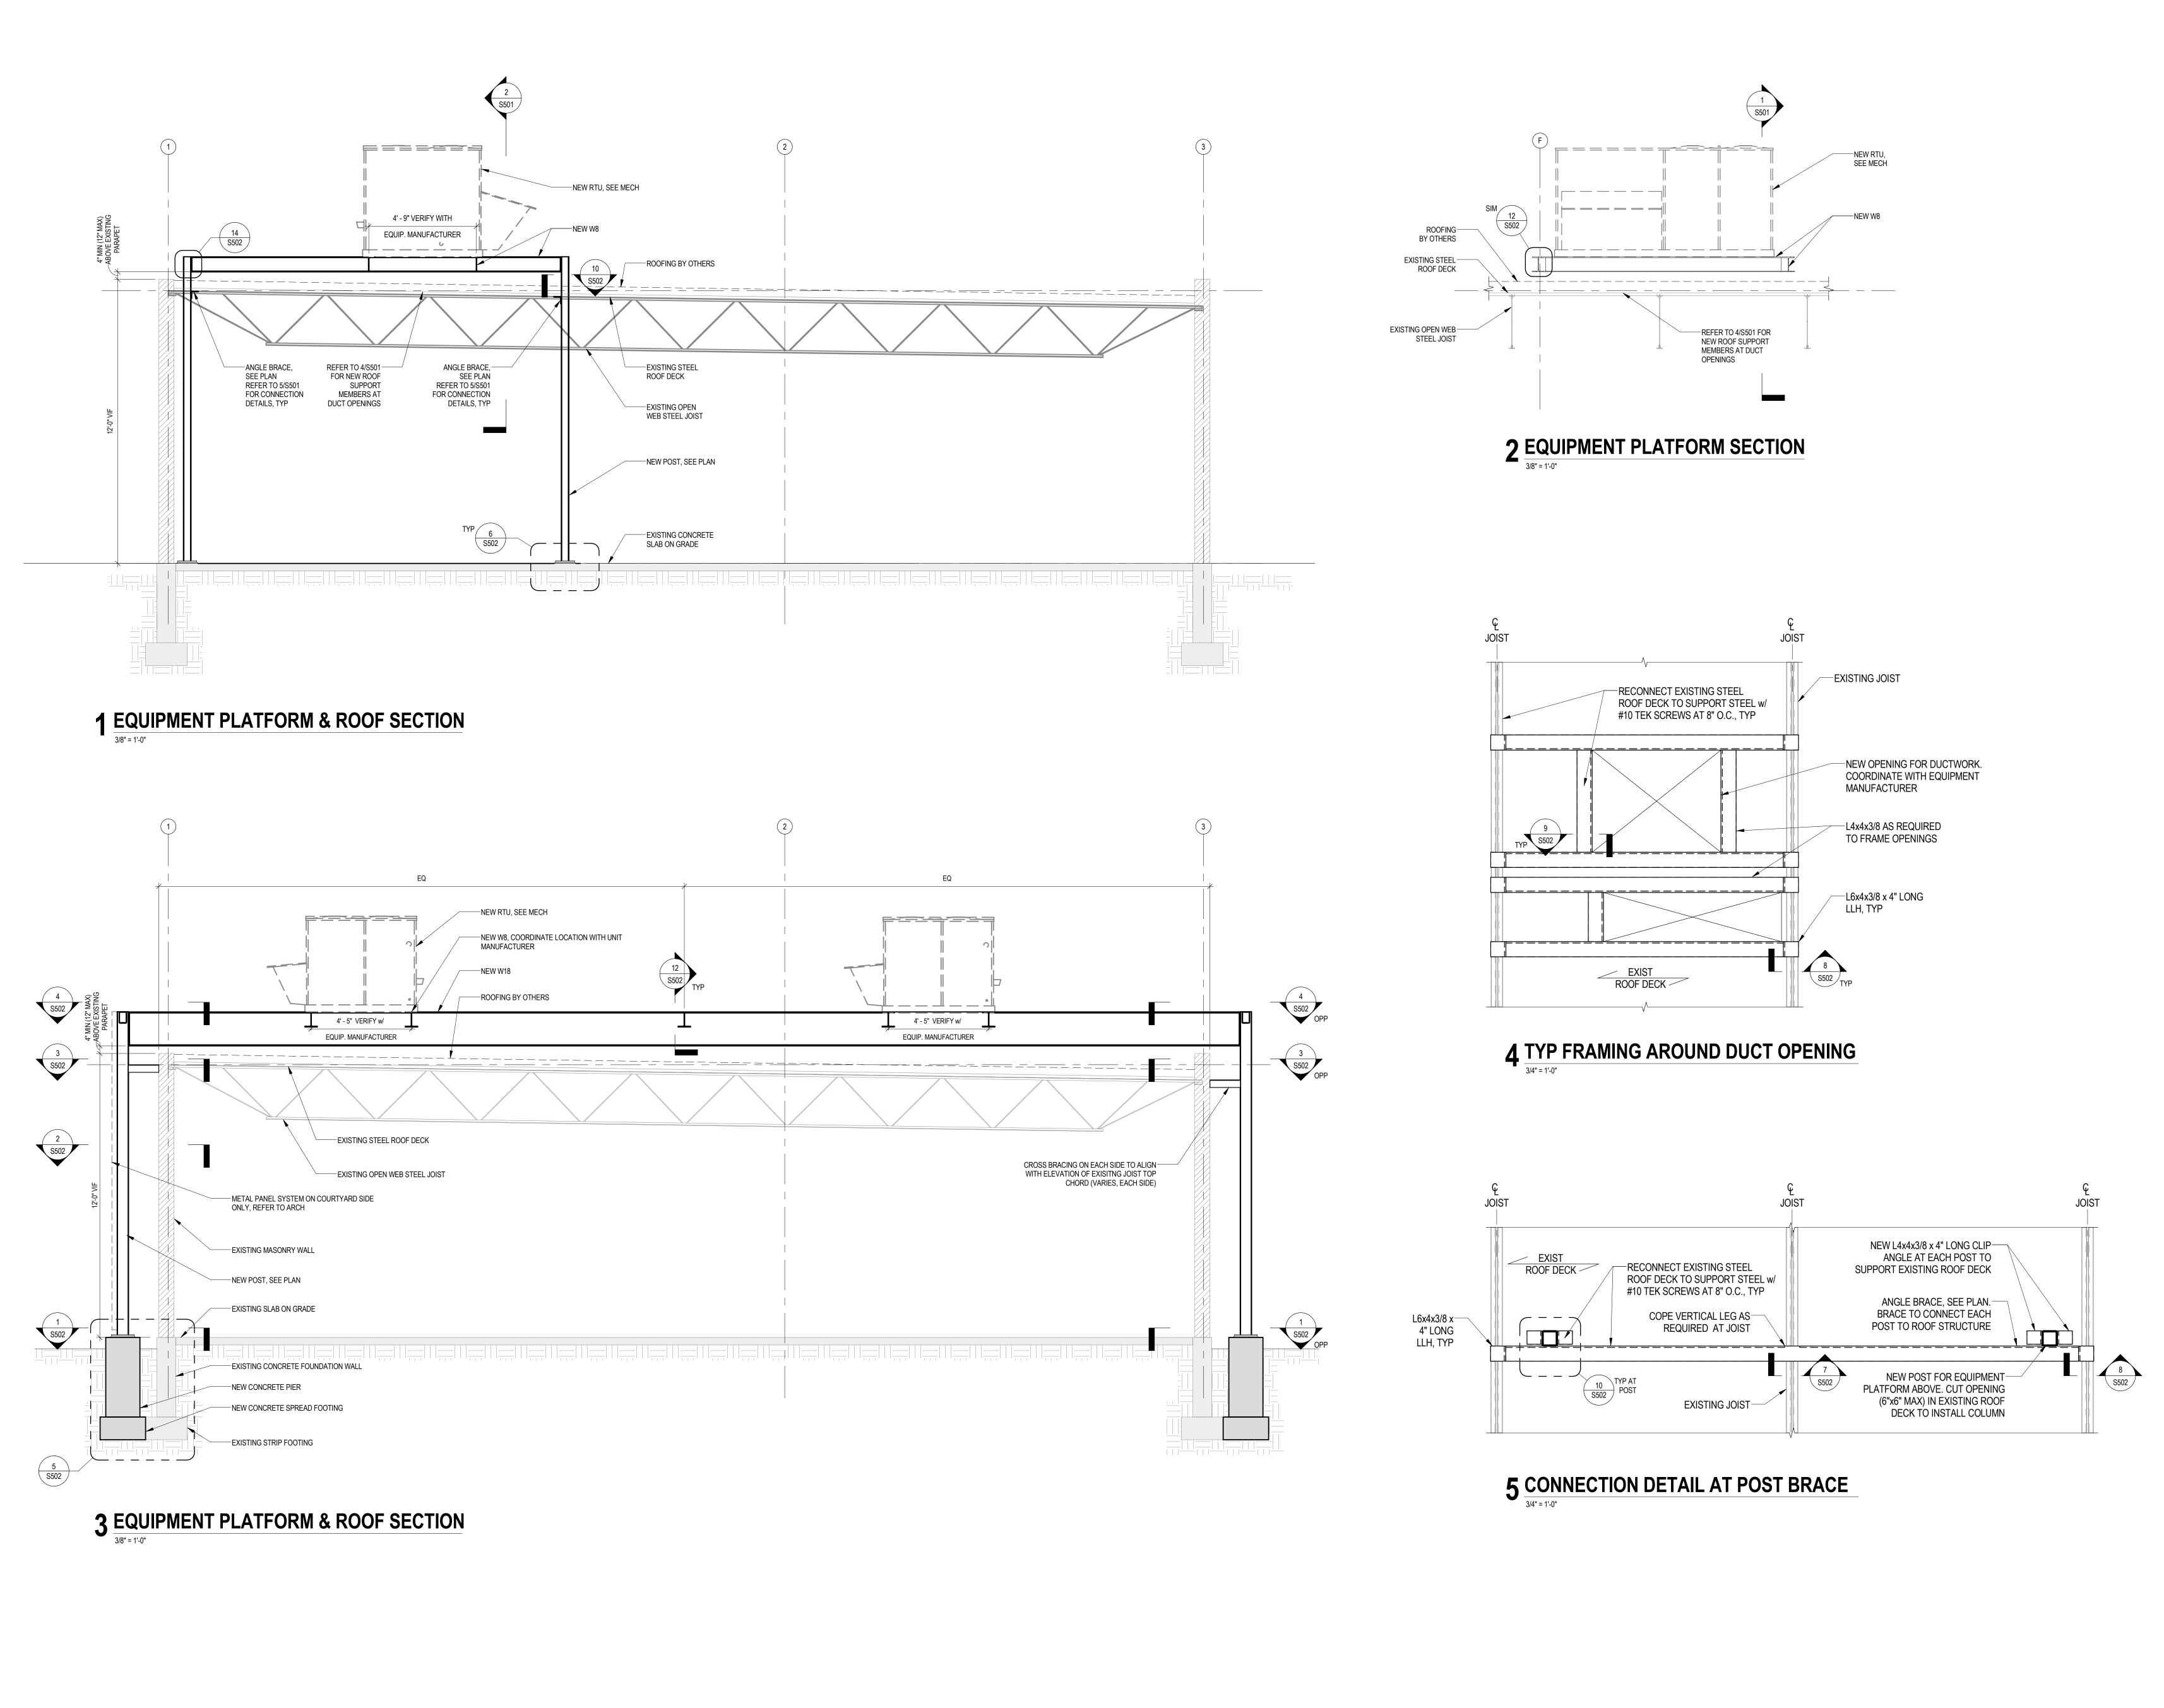

Robert W. Depke Juvenile Justice Complex RTU Replacement ²⁴⁶⁴⁷ N Milwaukee Ave, Vernon Hills, IL 60061
Dwg. Title
STRUCUTRAL SECTION
AND DETAILS
Project No. CHI-00240054-A1
Dwg. No.

1	ADDENDUM #1	06-29-2018		
No.	Revision	Date		
ISSUED FOR BID				
Profes	sional Seal(s)			
Drawn	By: Author			
Check	ed By: Checker			
Approv	Approver			
Date F	rinted: 06.18.2018			
File Na	me: CHI-00240054-A1.rfa			
Robert W. Depke Juvenile Justice Complex RTU Replacement				

• BUILDINGS • EARTH & ENVIRONMENT • ENERGY • • INDUSTRIAL • INFRASTRUCTURE • SUSTAINABILITY AUTION: DO NOT SCALE DRAWINGS. HIS REPRODUCTION MAY BE AT A SIZE DIFFERENT THAN ORIGINALLY DRAWN. EXP ASSUMES D RESPONSIBILITY FOR INCORRECT SCALING. UNAUTHORIZED REPRODUCTION OR REUSE IS RICITLY PROHIBITED. NOT PUBLISHED - ALL RIGHTS RESERVED. EXP EXPRESSLY DISCLAIMS ESPONSIBILITY ARISING FROM UNAUTHORIZED USE OF THESE DRAWINGS AND NOTES. JTHORIZATION MUST BE IN WRITING. xp, 2012


exp U.S. Services Inc.

www.exp.com

t: +1.312.616.0000 f: +1.312.616.6069 205 North Michigan Avenue, Suite 3600 Chicago, IL 60601 USA




11 SECTION 3" = 1'-0"

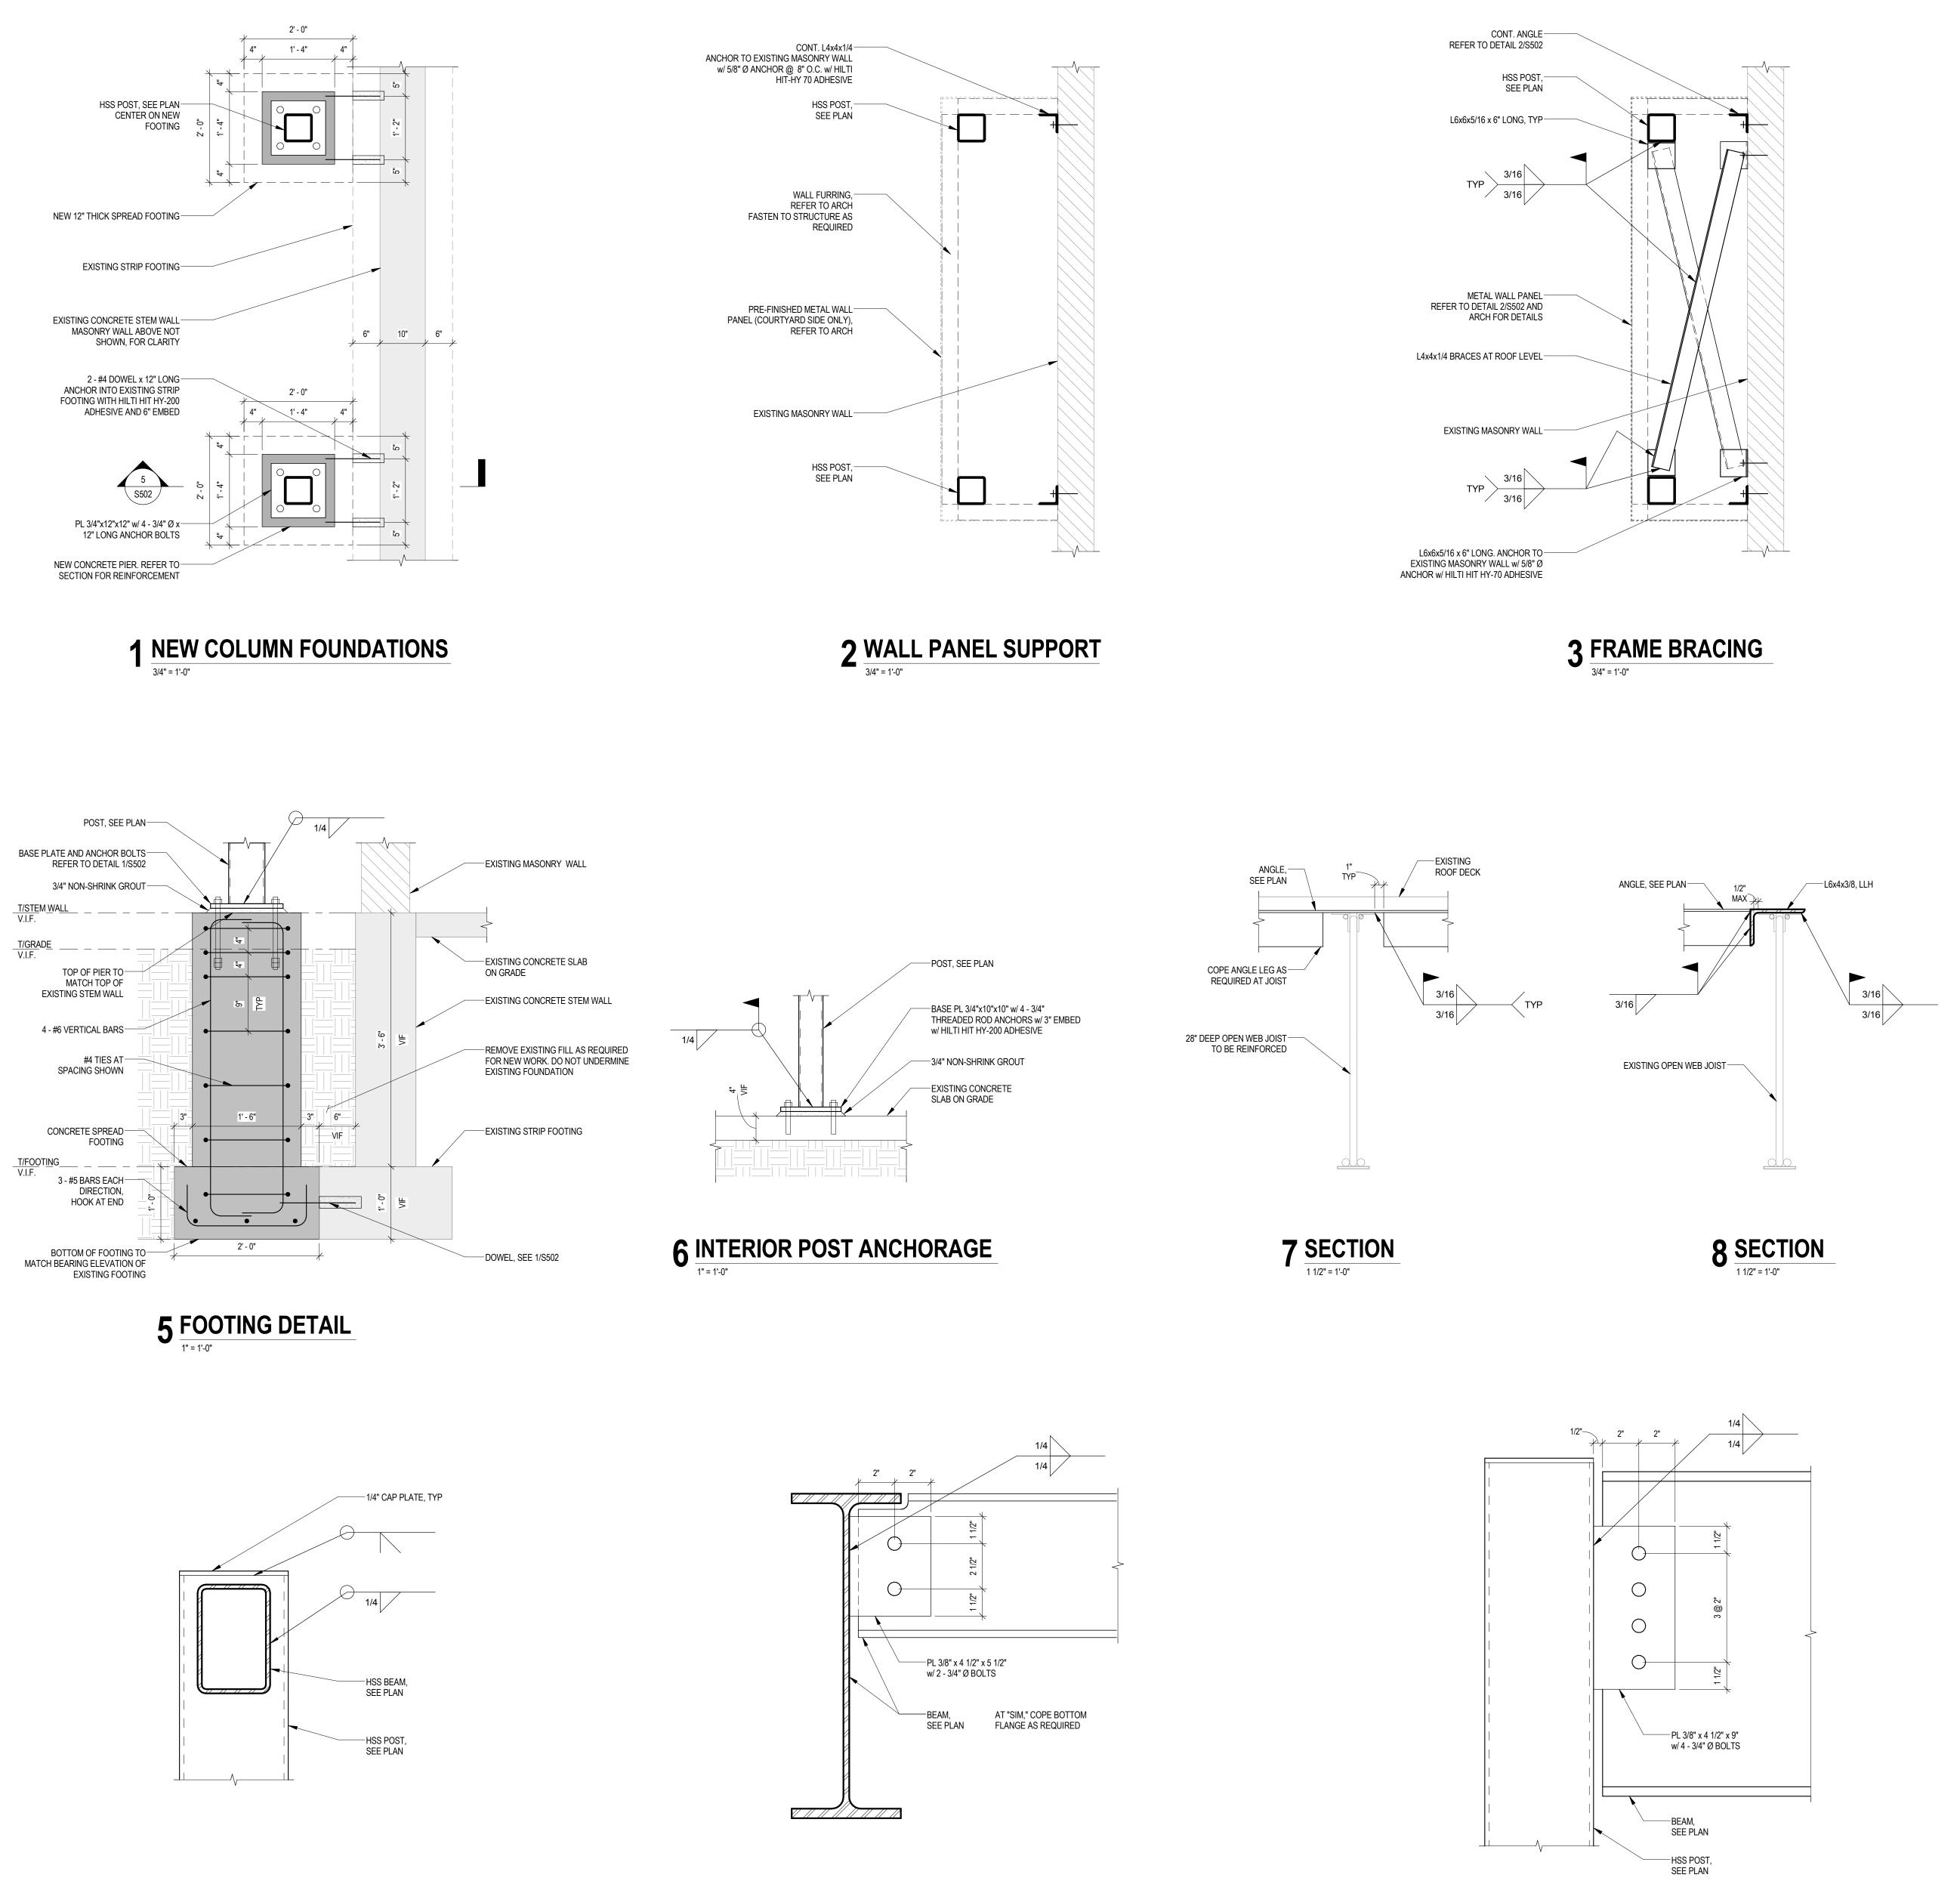


13 SECTION 3" = 1'-0"




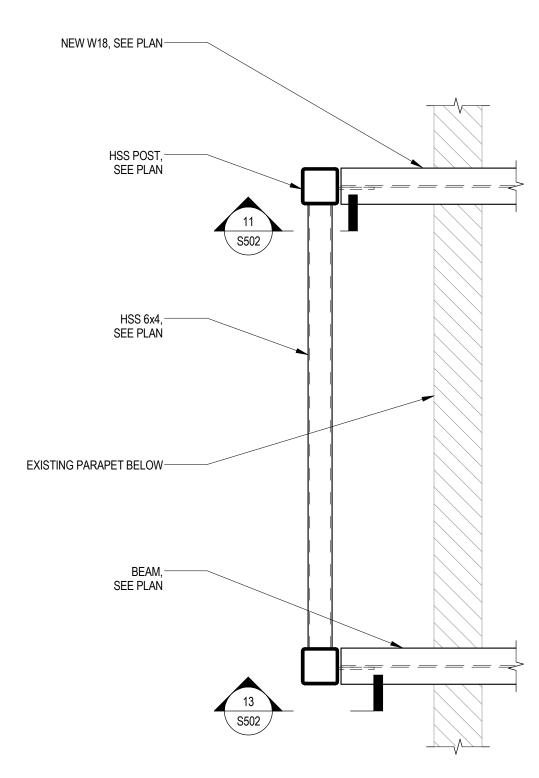


4 TOP OF FRAME

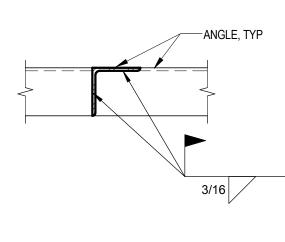

9 SECTION <u>1 1/2" = 1'-0"</u>

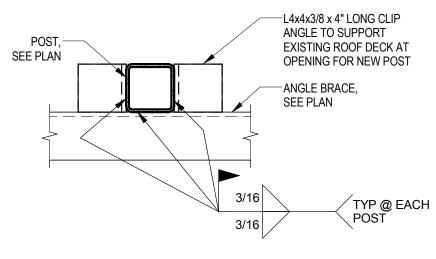

10 SECTION 1 1/2" = 1'-0"

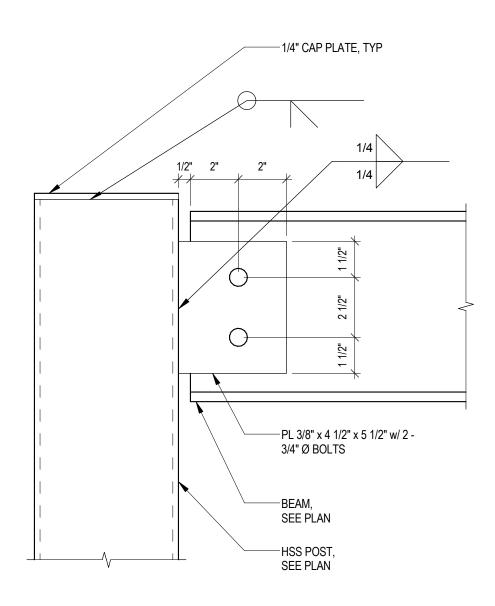

14 SECTION $\frac{3^{"}=1^{"}-0^{"}}{3^{"}=1^{"}-0^{"}}$

1	ADDENDUM #1	06-29-2018		
No.	Revision	Date		
	ISSUED FOR BID			
Profes	sional Seal(s)			
Drawn	By: DL			
Check	ed By: DL			
Approv	Approver			
Date P	rinted: 06.18.2018			
File Name: CHI-00240054-A1.rfa				
Projec				
Robert W. Depke Juvenile Justice Complex				
RTU Replacement				
24647 N Milwaukee Ave, Vernon Hills, IL 60061				
Dwg. 1				
STRUCTURAL SECTIONS				
AND DETAILS				
Project No.				
Project No. CHI-00240054-A1				
Dwg. No. 5502 1				

• BUILDINGS • EARTH & ENVIRONMENT • ENERGY • • INDUSTRIAL • INFRASTRUCTURE • SUSTAINABILITY AUTION: DO NOT SCALE DRAWINGS. HIS REPRODUCTION MAY BE AT A SIZE DIFFERENT THAN ORIGINALLY DRAWN. EXP ASSUMES O RESPONSIBILITY FOR INCORRECT SCALING. UNAUTHORIZED REPRODUCTION OR REUSE IS TRICTLY PROHIBITED. NOT PUBLISHED - ALL RIGHTS RESERVED. EXP EXPRESSLY DISCLAIMS ESPONSIBILITY ARISING FROM UNAUTHORIZED USE OF THESE DRAWINGS AND NOTES. UTHORIZATION MUST BE IN WRITING.

ехр.

t: +1.312.616.0000 f: +1.312.616.6069 205 North Michigan Avenue, Suite 3600 Chicago, IL 60601 USA www.exp.com

exp, 2012

exp U.S. Services Inc.